

MAR 30 1999

APPROVED

Date 10-29-98 *RAL*
CALHOUN COUNTY
REMONUMENTATION

CALHOUN COUNTY REMONUMENTATION
LAND CORNER RECORDATION CERTIFICATE
Filing Requirement of Act 74, Mich. P.A. 1970

STATE OF MICHIGAN
CALHOUN COUNTY
RECORDED

29 OCT 1998 2:42:24 PM

For corners in

<u>Calhoun</u> (County)	Located In:	Corner Code #
Lee		
1. Public Land Survey	T <u>1S</u> R <u>5W</u>	<u>1-8</u>
	T ___ R ___	_____
	T ___ R ___	_____
	T ___ R ___	_____
2. Property Controlling in Section	S ___ T ___ R ___	_____
	S ___ T ___ R ___	_____
3. Miscellaneous Property in Sec.	S ___ T ___ R ___	_____
	S ___ T ___ R ___	_____

ANNE B. NORLWAGER
CLERK - REGISTER OF DEEDS
LIBER **2073** PAGE **287**

Register of Deeds Stamp & File Number

4. Lot No. _____, Recorded Plat _____
5. Private Claims _____

	A	B	C	D	E	F	G	H	I	J	K	L
1												
2	6		5		4		3		2		1	
3												
4	7		8		9		10		11		12	
5												
6	18		17		16		15		14		13	
7												
8	19		20		21		22		23		24	
9												
10	30		29		28		27		26		25	
11												
12	31		32		33		34		35		36	
13												

I, Michael A. Groat, in a field survey on October 7, 1998 do hereby state that under requirements of P.A. 74, Michigan P.A. of 1970, the corner points mentioned in lines 1 and 2 above were in conformance with regulations and rules therefore as required in the current manual of survey instructions of the United States Department of the Interior, Bureau of Land Management or by a decree of a Court of Law and for that the corner points mentioned in lines 3, 4 and 5 above were in conformance with the rules of the Michigan Board of Land Surveyors or by a Decree of a Court of Law; established, re-established, monumented, recovered, found as expressed below:


NOTE: Not more than 2 corners, all in the same town and range, may be recorded on this certificate.

A. Description of original monument and accessories and/or subsequent restoration:
ORIGINAL SURVEY BY LUCIUS LYON, 1828, SET POST 10" TAMARACK, S 1° W 55 LKS
7" TAMARACK, S 68° W, 12 LKS.
1891, J.M. GIFFORD, MEASURED 40.5 CHAINS S OF NORTH CORNER & FOUND STUMPS OF BEARING TREES. SET STAKE, TAM 9", S 85° E 61 LKS.

B. Description of corner evidence found and/or method applied in restoring or reestablishing corner:
WENT TO APPROXIMATE AREA. FENCE IS RUNNING NORTH & SOUTH. FOUND OLD FENCE RUNNING EAST. EXCAVATED A 10'X12' AREA AND FOUND SEVERAL LARGE ROCKS. POSSIBLE REMAINS OF 9" TAM. WITNESSED BY GIFFORD. THE INTERSECTION OF THE OLD FENCE EAST WITH THE N-S FENCE MEASURES 2677.04 FEET SOUTH OF THE CORNER TO THE NORTH. GIFFORD MEASURED 2673 (40.5 CHS). THERE IS A FENCE RUNNING WEST 28± SOUTH. THIS AREA WAS EXCAVATED ALSO BUT NOTHING WAS FOUND. THIS POSITION WOULD BE OVER 2700' SOUTH OF CORNER TO THE NORTH. SET A BERNTSEN MONUMENT AT THE INTERSECTION OF THE N-S FENCE WITH THE OLD FENCE EAST.

C. Description of monument for corner and accessories established to perpetuate locating the position of the corner:

SET BERNTSEN MONUMENT WITH CARSONITE MARKER BESIDE
NAIL & SPOTTER IN 10" WALNUT, EAST, 1.95'
NAIL & SPOTTER IN 20" CHERRY, N 47° E, 9.23'
NAIL & SPOTTER IN 15" CHERRY, S 20° E, 30.95'
NAIL & SPOTTER IN 6" WALNUT, S 70° W, 33.60'

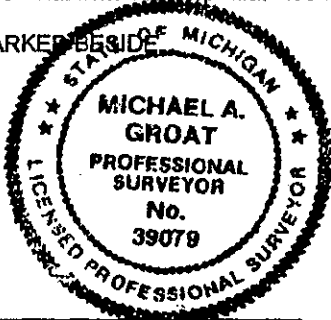

Signed by *Michael A. Groat*

Date October 7, 1998

Surveyor's Michigan License No. 39079