

APPROVED

Date 12-16-97 RRC
**CALHOUN COUNTY
REMONUMENTATION.**

**CALHOUN COUNTY REMONUMENTATION
LAND CORNER RECORDATION CERTIFICATE
Filing Requirement of Act 74, Mich. P.A. 1970**

STATE OF MICHIGAN
CALHOUN COUNTY
RECORDED

19 DEC 97 2:38 P.M.

ANNE B. NORLANDER
CLERK - REGISTER OF DEEDS

LIBER 1985 PAGE 525

Register of Deeds Stamp & File Number

For corners in

<u>CALHOUN</u> (County)	Located In:	Corner Code #
LEE		
1. Public Land Survey	T <u>1S</u> R <u>5W</u>	<u>J-9</u>
	T _____ R _____	_____
	T _____ R _____	_____
	T _____ R _____	_____
2. Property Controlling in Section	S _____ T _____ R _____	_____
	S _____ T _____ R _____	_____
3. Miscellaneous Property in Sec.	S _____ T _____ R _____	_____
	S _____ T _____ R _____	_____

4. Lot No. _____, Recorded Plat _____
5. Private Claims _____

I, MICHAEL A. GROAT, in a field survey on DECEMBER 9, 1997 do hereby state that under requirements of P.A. 74, Michigan P.A. of 1970, the corner points mentioned in lines 1 and 2 above were in conformance with regulations and rules therefore as required in the current manual of survey instructions of the United States Department of the Interior, Bureau of Land Management or by a decree of a Court of Law and /or that the corner points mentioned in lines 3, 4 and 5 above were in conformance with the rules of the Michigan Board of Land Surveyors or by a Decree of a Court of Law; established, re-established, monumented, recovered, found as expressed below:

NOTE: Not more than 2 corners, all in the same town and range, may be recorded on this certificate.

	A	B	C	D	E	F	G	H	I	J	K	L	M
1													
2	6		5		4		3		2		1		
3													
4	7		8		9		10		11		12		
5													
6	18		17		16		15		14		13		
7													
8	19		20		21		22		23		24		
9													
10	30		29		28		27		26		25		
11													
12	31		32		33		34		35		36		
13													

A. Description of original monument and accessories and/or subsequent restoration:

1825, MULLET, DEPUTY SURVEYOR, SET STAKE, TAMARACK, 7", N87°E, 71 LINKS;
TAMARACK, 6", S20°W, 104 LINKS

1891, GIFFORD, FOUND ONE STUMP OF GOVERNMENT BEARING TREE AND SET FIRECLAY. 3" POPPLE, S2°E, 7 LINKS; 3" POPPLE, NORTH, 5 LINKS.

1894, COURTRIGHT, RAN THE SOUTH LINE OF SECTION 23 AND FOUND GIFFORDS CORNER TO BE IN THE ERROR. SET A CORNER MID WAY ON LINE BETWEEN THE TWO OPPOSING CORNERS. IT WAS 13 FEET EAST AND 24-1/2 FEET NORTH OF THE GIFFORD CORNER.


B. Description of corner evidence found and/or method applied in restoring or reestablishing corner:

FOUND A 1-1/2" PIPE AT A OLD FENCE INTERSECTION. SEARCHED 13' WEST AND 24-1/2 FEET SOUTH AND FOUND A BURIED PILE OF STONES. ACCEPTED THE 1-1/2" PIPE AS THE BEST LOCATION OF THE CORNER SET BY MULLET.

C. Description of monument for corner and accessories established to perpetuate locating the position of the corner:

SET BERNTSEN MONUMENT WITH CARSONITE MARKER BESIDE. STAMPED SECTION INFORMATION AND LICENSE NUMBER IN BRASS CAP.

S60°E, NAIL AND TAG IN WESTERLY SIDE OF 18" POPPEL, 10.0'
N75°W, NAIL AND TAG IN NORTHERLY SIDE OF 10" POPPEL, 18.5'
NORTH, FENCE POST, 1.0'
N10°E, NAIL AND TAG IN EASTERLY SIDE OF 8" MAPLE, 8.0'
FENCE RUNNING EAST AND WEST

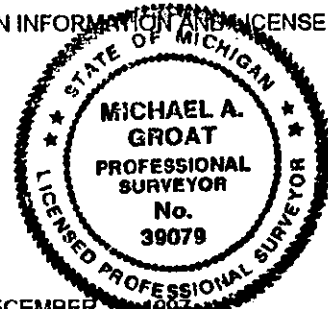

Signed by [Signature] Date DECEMBER 11, 1997
Surveyor's Michigan License No. 39079

**SURVEY &
REMONUMENTATION**

APR 07 1998

SECTION