

# APPROVED

Date 12-16-97 RRL

**CALHOUN COUNTY CALHOUN COUNTY REMONUMENTATION LAND CORNER RECORDATION CERTIFICATE**  
**Filing Requirement of Act 74, Mich. P.A. 1970**

STATE OF MICHIGAN  
 CALHOUN COUNTY  
 RECORDED

19 DEC 97 2:38 P.M.

ANNE B. NORLANDER  
 CLERK - REGISTER OF DEEDS

LIRER **1985** PAGE **528**

Register of Deeds Stamp & File Number

For corners in

<u>CALHOUN</u> (County)	Located In:	Corner Code #
LEE		
1. Public Land Survey	T <u>1S</u> R <u>5W</u>	<u>K-8</u>
	T ___ R ___	_____
	T ___ R ___	_____
	T ___ R ___	_____
2. Property Controlling in Section	S ___ T ___ R ___	_____
	S ___ T ___ R ___	_____
3. Miscellaneous Property in Sec.	S ___ T ___ R ___	_____
	S ___ T ___ R ___	_____

4. Lot No. \_\_\_\_\_, Recorded Plat \_\_\_\_\_  
 5. Private Claims \_\_\_\_\_

I, MICHAEL A. GROAT, in a field survey on DECEMBER 15, 1997 do hereby state that under requirements of P.A. 74, Michigan P.A. of 1970, the corner points mentioned in lines 1 and 2 above were in conformance with regulations and rules therefore as required in the current manual of survey instructions of the United States Department of the Interior, Bureau of Land Management or by a decree of a Court of Law and for that the corner points mentioned in lines 3, 4 and 5 above were in conformance with the rules of the Michigan Board of Land Surveyors or by a Decree of a Court of Law; established, re-established, monumented, recovered, found as expressed below:

NOTE: Not more than 2 corners, all in the same town and range, may be recorded on this certificate.

	A	B	C	D	E	F	G	H	I	J	K	L	M
1													
2		6		5		4		3		2		1	
3													
4		7		8		9		10		11		12	
5													
6		16		17		16		15		14		13	
7													
8		19		20		21		22		23		24	
9													
10		30		29		28		27		26		25	
11													
12		31		32		33		34		35		36	
13													

A. Description of original monument and accessories and/or subsequent restoration:

MULLET, 1828, SET STAKE, 10" TAMARACK, S75°W, 40 LINKS, 9" TAMARACK, S3-1/2°W, 19 LINKS

GIFFORD, 1891, SET FIRECLAY TILE, 8" TAMARACK, S48°W, 88 LINKS


B. Description of corner evidence found and/or method applied in restoring or reestablishing corner:

FOUND A 1/2" IRON 11 FEET WEST OF WEST EDGE OF 23 MILE ROAD. THE WHOLE AREA IN A MUCK FARM AND A LOT OF FILL HAS BEEN PLACE TO GET THE ROAD IN. THE IRON APPEARS TO HAVE BEEN SET MID-WAY ON LINE BETWEEN THE TWO OPPOSING CORNERS. ACCEPTED AS THE BEST LOCATION OF THE ORIGINAL CORNER SET BY MULLET.

C. Description of monument for corner and accessories established to perpetuate locating the position of the corner:

SET BERNTSEN MONUMENT STAMPED WITH SECTION INFORMATION AND LICENSE NUMBER IN THE BRASS CAP.

2657.84' TO THE CORNERS NORTH AND SOUTH  
 S45°E, NORTHWEST CORNER OF CONCRETE BUILDING, 137.28'  
 S60°E, NAIL AND TAG IN POLE BY PHONE BOX, 47.35'  
 S80°E, NAIL AND TAG IN UTILITY POLE, 100.0'  
 N65°E, NAIL AND TAG IN 12" ELM, 74.60'  
 21' EAST OF DITCH RUNNING NORTH AND SOUTH

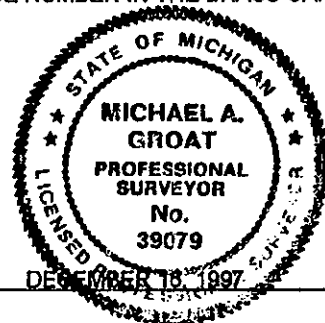

Signed by [Signature] SURVEY & REMONUMENTATION DECEMBER 18, 1997

Surveyor's Michigan License No. 39079

APR 07 1998

SECTION