

APPROVED

Date 7-21-99 RR

CALHOUN COUNTY REMONUMENTATION.

CALHOUN COUNTY REMONUMENTATION LAND CORNER RECORDATION CERTIFICATE Filing Requirement of Act 74, Mich. P.A. 1970

<u>CALHOUN</u> (County)	Located In:	Corner Code #
CONVIS TOWNSHIP	T <u>1S</u> R <u>6W</u>	<u>B-11</u>
1. Public Land Survey	T _____ R _____	_____
	T _____ R _____	_____
	T _____ R _____	_____
2. Property Controlling in Section	S _____ T _____ R _____	_____
	S _____ T _____ R _____	_____
3. Miscellaneous Property in Sec.	S _____ T _____ R _____	_____

STATE OF MICHIGAN
CALHOUN COUNTY
RECORDED

27 JUL 1999 10:26:27 AM

ANNE B. NORLANDER
CLERK - REGISTER OF DEEDS

LIBER **2147** PAGE **709**

Register of Deeds Stamp & File Number

4. Lot No. _____, Recorded Plat _____
5. Private Claims _____

I, ROBERT R. CARR, in a field survey on JUNE 25, 1999 do hereby state that under requirements of P.A. 74, Michigan P.A. of 1970, the corner points mentioned in lines 1 and 2 above were in conformance with regulations and rules therefore as required in the current manual of survey instructions of the United States Department of the Interior, Bureau of Land Management or by a decree of a Court of Law and /or that the corner points mentioned in lines 3, 4 and 5 above were in conformance with the rules of the Michigan Board of Land Surveyors or by a Decree of a Court of Law; established, re established, monumented, recovered, found as expressed below:

NOTE: Not more than 2 corners, all in the same town and range, may be recorded on this certificate.

A. Description of original monument and accessories and/or subsequent restoration:

G.L.O. CORNER SET BY SYVESTER SIBLEY D.S. 1826.

1	A	B	C	D	E	F	G	H	I	J	K	L	M
2		6		5		4		3		2		1	
3													
4		7		8		9		10		11		12	
5													
6		18		17		16		15		14		13	
7													
8		19		20		21		22		23		24	
9													
10		30		29		28		27		26		25	
11		⊙											
12		31		32		33		34		35		36	
13													


SURVEY & REMONUMENTATION

MAR 13 2000

SECTION

B. Description of corner evidence found and/or method applied in restoring or reestablishing corner:

CORNER OBLITERATED.
SET CORNER BY PROJECTING NORTH-SOUTH 1/4 LINE FROM SOUTH 1/4 POST NORTH THROUGH 4" STEEL POST SET IN CONCRETE AT CENTER OF SECTION.
THIS LOCATION IS 21.56' WEST OF PRORATED G.L.O. HOWEVER STRONG NORTH AND SOUTH 1/4 LINE OCCUPATION (OLD FENCE/STONE AND TREE ROW) FROM SOUTH 1/4 POST TO SEVERAL HUNDRED FEET NORTH OF CENTER OF SECTION SUPPORTS THIS LOCATION.
PLACED STANDARD CALHOUN COUNTY REMONUMENTATION MONUMENT IN CASTING.

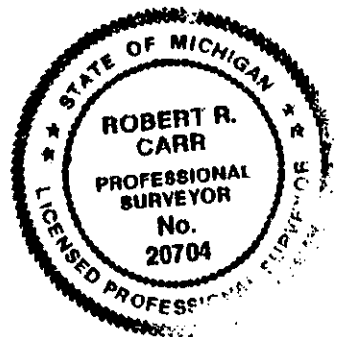

C. Description of monument for corner and accessories established to perpetuate locating the position of the corner:

BERNTSEN MONUMENT IN CASTING:
24" WILLOW S 08°E, 29.06' (NAIL AND SPOTTER)
40" OAK S 59°W, 110.90' (NAIL AND SPOTTER)
36" OAK S 81°W, 116.35' (NAIL AND SPOTTER)
RAIL ROAD TIE POST S 43°W, 54.32' (NAIL AND SPOTTER)

THIS LOCATION IS ACCEPTED AS THE BEST AVAILABLE EVIDENCE OF THE POSITION OF THE ORIGINAL CORNER.

Signed by [Signature]
Surveyor's Michigan License No. 20704 ROBERT R. CARR

Date 7-21-99