

APPROVED

Date 9-15-99 RRC
CALHOUN COUNTY
REMONUMENTATION
For corners in

CALHOUN COUNTY REMONUMENTATION
LAND CORNER RECORDATION CERTIFICATE
Filing Requirement of Act 74, Mich. P.A. 1970

STATE OF MICHIGAN
CALHOUN COUNTY
RECORDED

29 SEP 1999 10:30:33 AM

ANNE R. NORLANDER
CLERK - REGISTER OF DEEDS

LIBER 2164 PAGE 713

Register of Deeds Stamp & File Number

<u>CALHOUN</u>	Located In:	Corner Code #
(County)		
CONVIS TOWNSHIP		
1. Public Land Survey	T <u>1S</u> R <u>6W</u>	<u>C-12</u>
	T _____ R _____	_____
	T _____ R _____	_____
	T _____ R _____	_____
2. Property Controlling	S _____ T _____ R _____	_____
in Section	S _____ T _____ R _____	_____
3. Miscellaneous	S _____ T _____ R _____	_____
Property in Sec.	S _____ T _____ R _____	_____

4. Lot No. _____, Recorded Plat _____
5. Private Claims _____

I, ROBERT R. CARR, in a field survey on AUGUST 8, 1999 do hereby state that under requirements of P.A. 74, Michigan P.A. of 1970, the corner points mentioned in lines 1 and 2 above were in conformance with regulations and rules therefore as required in the current manual of survey instructions of the United States Department of the Interior, Bureau of Land Management or by a decree of a Court of Law and/or that the corner points mentioned in lines 3, 4 and 5 above were in conformance with the rules of the Michigan Board of Land Surveyors or by a Decree of a Court of Law; established, re-established, monumented, recovered, found as expressed below:

NOTE: Not more than 2 corners, all in the same town and range, may be recorded on this certificate.

A. Description of original monument and accessories and/or subsequent restoration:

ORIGINAL CORNER SET BY SYLVESTER SIBLEY 1826.

NO SUBSEQUENT RESTORATION FOUND.

SURVEY &
REMONUMENTATION

MAR 13 2000

SECTION

	A	B	C	D	E	F	G	H	I	J	K	L	M
1													
2	6		5		4		3		2		1		
3													
4	7		8		9		10		11		12		
5													
6	18		17		16		15		14		13		
7													
8	19		20		21		22		23		24		
9													
10	30		29		28		27		26		25		
11													
12	31	⊕	32		33		34		35		36		
13													


B. Description of corner evidence found and/or method applied in restoring or reestablishing corner:

SET CORNER ON LINE BETWEEN CORNERS C-11 AND C-13 AND IN LINE WITH LONG STANDING OCCUPATION AT B-12 (CENTER OF SECTION) AND PREVIOUSLY ESTABLISHED A-12 (WEST 1/4 POST). SET BERNTSEN MONUMENT OVER LARGE TREE ROOT IN MOUND OF STONES.

C. Description of monument for corner and accessories established to perpetuate locating the position of the corner:

BERNTSEN MONUMENT WITH CARSONITE WITNESS POST 1' ± NW.
14" OAK, S03°W 45.28 FEET SET NAIL AND SPOTTER
36" OAK, S50°W 3.43 FEET SET NAIL AND SPOTTER
8" MAPLE, N62°E 27.10 FEET SET NAIL AND SPOTTER
14" OAK, S40°E 39.65 FEET SET NAIL AND SPOTTER

AND IS ACCEPTED AS THE BEST AVAILABLE EVIDENCE OF THE POSITION OF THE ORIGINAL CORNER.

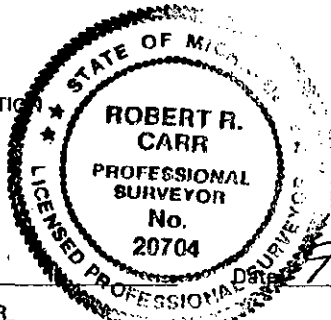

Signed by [Signature]
Surveyor's Michigan License No. 20704 ROBERT R. CARR