

**SURVEY & REMONUMENTATION**

MAR 18 2000

SECTION

**APPROVED**

Date 7-21-99 *RL*

**CALHOUN COUNTY REMONUMENTATION  
LAND CORNER RECORDATION CERTIFICATE  
Filing Requirement of Act 74, Mich. P.A. 1970**

**CALHOUN COUNTY**  
REMONUMENTATION  
For corners in

|                                    |                         |               |
|------------------------------------|-------------------------|---------------|
| <u>CALHOUN</u>                     | Located In:             | Corner Code # |
| (County)                           |                         |               |
| CONVIS TOWNSHIP                    |                         |               |
| 1. Public Land Survey              | T <u>1S</u> R <u>6W</u> | <u>C-13</u>   |
|                                    | T _____ R _____         | _____         |
|                                    | T _____ R _____         | _____         |
|                                    | T _____ R _____         | _____         |
| 2. Property Controlling in Section | S _____ T _____ R _____ | _____         |
|                                    | S _____ T _____ R _____ | _____         |
| 3. Miscellaneous Property in Sec.  | S _____ T _____ R _____ | _____         |
|                                    | S _____ T _____ R _____ | _____         |

STATE OF MICHIGAN  
CALHOUN COUNTY  
RECORDED

27 JUL 1999 10:27:05 AM

ANNE B. NORLANDER  
CLERK - REGISTER OF DEEDS

LIBER **2147** PAGE **712**

Register of Deeds Stamp & File Number

4. Lot No. \_\_\_\_\_, Recorded Plat \_\_\_\_\_  
5. Private Claims \_\_\_\_\_

I, ROBERT R. CARR, in a field survey on JUNE 25, 1999 do hereby state that under requirements of P.A. 74, Michigan P.A. of 1970, the corner points mentioned in lines 1 and 2 above were in conformance with regulations and rules therefore as required in the current manual of survey instructions of the United States Department of the Interior, Bureau of Land Management or by a decree of a Court of Law and /or that the corner points mentioned in lines 3, 4 and 5 above were in conformance with the rules of the Michigan Board of Land Surveyors or by a Decree of a Court of Law; established, re-established, monumented, recovered, found as expressed below:

NOTE: Not more than 2 corners, all in the same town and range, may be recorded on this certificate.


**A. Description of original monument and accessories and/or subsequent restoration:**

G.L.O. CORNER SET BY SYLVESTER SIBLEY D.S. IN 1826.  
ROBERT R. CARR P.S. NO. 20704, 1998, CORNER GONE, SET CORNER AT G.L.O.  
DISTANCE 9.25' WEST OF THE RESURVEY TILE FOUND AT C-1 OF MARSHALL TOWNSHIP AND ON LINE PROJECTED FROM D-13 CONVIS TOWNSHIP THROUGH C-1 OF MARSHALL TOWNSHIP.

|    | A  | B | C  | D | E  | F | G  | H | I  | J | K | L | M  |
|----|----|---|----|---|----|---|----|---|----|---|---|---|----|
| 1  |    |   |    |   |    |   |    |   |    |   |   |   |    |
| 2  | 6  |   | 5  |   | 4  |   | 3  |   | 2  |   |   |   | 1  |
| 3  |    |   |    |   |    |   |    |   |    |   |   |   |    |
| 4  | 7  |   | 8  |   | 9  |   | 10 |   | 11 |   |   |   | 12 |
| 5  |    |   |    |   |    |   |    |   |    |   |   |   |    |
| 6  | 18 |   | 17 |   | 16 |   | 15 |   | 14 |   |   |   | 13 |
| 7  |    |   |    |   |    |   |    |   |    |   |   |   |    |
| 8  | 19 |   | 20 |   | 21 |   | 22 |   | 23 |   |   |   | 24 |
| 9  |    |   |    |   |    |   |    |   |    |   |   |   |    |
| 10 | 30 |   | 29 |   | 28 |   | 27 |   | 26 |   |   |   | 25 |
| 11 |    |   |    |   |    |   |    |   |    |   |   |   |    |
| 12 | 31 |   | 32 |   | 33 |   | 34 |   | 35 |   |   |   | 36 |
| 13 |    |   |    |   |    |   |    |   |    |   |   |   |    |

**B. Description of corner evidence found and/or method applied in restoring or reestablishing corner:**

REPLACED IRON I SET IN 1998 WITH STANDARD CALHOUN COUNTY REMONUMENTATION MONUMENT IN CASTING.

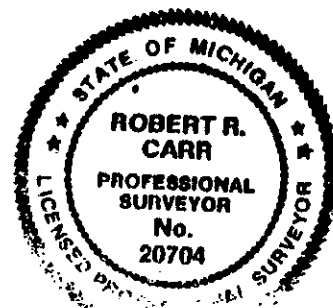

**C. Description of monument for corner and accessories established to perpetuate locating the position of the corner:**

BERNTSEN MONUMENT IN CASTING:  
40" MAPLE S 40°E, 50.49' (NAIL AND SPOTTER)  
40" MAPLE S 40°W, 38.09' (NAIL AND SPOTTER)  
10" MAPLE N 71°E, 60.45' (NAIL AND SPOTTER)  
18" MAPLE N 75°W, 157.25' (NAIL AND SPOTTER)

THIS LOCATION IS ACCEPTED AS A CAREFUL AND FAITHFUL REESTABLISHMENT OF THE POSITION OF THE ORIGINAL CORNER.

Signed by *Robert R. Carr*

Date 7-21-99

Surveyor's Michigan License No. 20704 ROBERT R. CARR