

APPROVED

Date 7-27-94 DDW
CALHOUN COUNTY
REMONUMENTATION.

CALHOUN COUNTY REMONUMENTATION
LAND CORNER RECORDATION CERTIFICATE
Filing Requirement of Act 74, Mich. P.A. 1970

STATE OF MICHIGAN
CALHOUN COUNTY
RECORDED

28 JUL 94 11:12 A.M.

ANNE B. NORLANDER
CLERK - REGISTER OF DEEDS

For corners in
Calhoun

(County)

Located In:

Corner Code #

- | | | | |
|------------------------------------|--------------|--------------|---------|
| 1. Public Land Survey | T <u>1</u> S | R <u>6</u> W | I-12 |
| | T _____ | R _____ | _____ |
| | T _____ | R _____ | _____ |
| | T _____ | R _____ | _____ |
| 2. Property Controlling in Section | S _____ | T _____ | R _____ |
| | S _____ | T _____ | R _____ |
| 3. Miscellaneous Property in Sec. | S _____ | T _____ | R _____ |
| | S _____ | T _____ | R _____ |

Register of Deeds Stamp & File Number

4. Lot No. _____, Recorded Plat _____
5. Private Claims _____

Donald J. Davis, in a field survey on July 7, 19 94, do hereby certify that under requirements of P.A. 74, Michigan P.A. of 1970, the corner points mentioned in lines 1 and 2 above were in conformance with regulations and rules therefore as required in the current manual of survey instructions of the United States Department of the Interior, Bureau of Land Management or by a decree of a Court of Law and/or that the corner points mentioned in lines 3, 4 and 5 above were in conformance with the rules of the Michigan Board of Land Surveyors or by a Decree of a Court of Law; established, re-established, monumented, re-monumented, recovered, found as expressed below:

NOTE: Not more than 4 corners, all in the same town and range, may be recorded on this certificate.

	A	B	C	D	E	F	G	H	I	J	K	L	M
2	6		5		4		3		2		1		
3													
4	7		8		9		10		11		12		
5													
6	18		17		16		15		14		13		
7													
8	19		20		21		22		23		24		
9													
10	30		29		28		27		26		25		
11													
12	31		32		33		34		35		36		
13													

A. Description of original monument and accessories and/or subsequent restoration:

- | | |
|--------------------------------|----------------------------|
| 1825 Lyon | M.D.S.H. Corbit, 1966. |
| 14" White Oak S 43° W 40 links | 1" diameter Steel pin. |
| 9" White Oak N 4° E 16 links | 16" Cherry N 23° E 67.02' |
| | 16" Hickory S 89° W 23.87' |
| | 29" Oak S 65° E 31.67' |

B. Description of corner evidence found and/or method applied in restoring or reestablishing corner:

Found 1" steel pin called for by Corbit, checked into witnesses.
Accepted as good perpetuation of corner.

SURVEY &
REMONUMENTATION


OCT 24 1994

COMMISSION

LIBER 1760 PAGE 636

C. Description of monument for corner and accessories established to perpetuate locating the position of the corner:

- Set Berntsen monument and monument box.,
Nail & Spotter in 24" Maple N 60° E 38.30'
Nail & Spotter in 20" Hickory S 89° W 23.87' (old).
Nail & Spotter in 18" Oak S 70° W 32.15'
Nail & Spotter in 32" Oak S 65° E 31.67' (old)

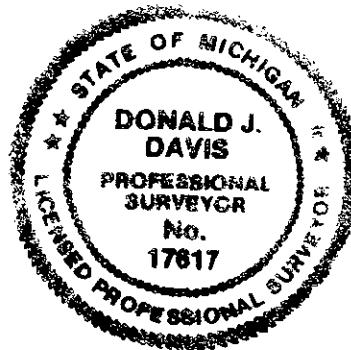

Signed by Donald J. Davis
Surveyor's Michigan License No. 17617

Date July 25, 1994