

MAR 30 1999

APPROVED

Date 12-9-98 REC
CALHOUN COUNTY
REMONUMENTATION.

CALHOUN COUNTY REMONUMENTATION
LAND CORNER RECORDATION CERTIFICATE
Filing Requirement of Act 74, Mich. P.A. 1970

STATE OF MICHIGAN
CALHOUN COUNTY
RECORDED

For corners in

CALHOUN (County)	Located In:	Corner Code #
CONVIS TOWNSHIP		
1. Public Land Survey	T <u>1S</u> R <u>6W</u>	<u>J-3</u>
	T _____ R _____	_____
	T _____ R _____	_____
	T _____ R _____	_____
2. Property Controlling in Section	S _____ T _____ R _____	_____
	S _____ T _____ R _____	_____
3. Miscellaneous Property in Sec.	S _____ T _____ R _____	_____
	S _____ T _____ R _____	_____

15 DEC 1998 3:41:43 PM

ANNE B. NORLANDER
CLERK - REGISTER OF DEEDS

LIBER **2087** PAGE **949**

Register of Deeds Stamp & File Number

4. Lot No. _____, Recorded Plat _____
5. Private Claims _____

I, ROBERT R. CARR, in a field survey on DECEMBER 8, 19 98 do hereby state that under requirements of P.A. 74, Michigan P.A. of 1970, the corner points mentioned in lines 1 and 2 above were in conformance with regulations and rules therefore as required in the current manual of survey instructions of the United States Department of the Interior, Bureau of Land Management or by a decree of a Court of Law and /or that the corner points mentioned in lines 3, 4 and 5 above were in conformance with the rules of the Michigan Board of Land Surveyors or by a Decree of a Court of Law; established, re-established, monumented, recovered, found as expressed below:

NOTE: Not more than 2 corners, all in the same town and range, may be recorded on this certificate.

1/4 POST COMMON TO SECTIONS 2 & 11

A. Description of original monument and accessories and/or subsequent restoration:

ORIGINAL CORNER SET BY SYVESTER SIBLEY, D.S. 1826

A.H. CHASE, 1909 SURVEY FOR A.B. WINANS
FOUND SOUTH 1/4 POST OF SECTION 2 FROM TAP ROOTS OF BOTH
U.S. BEARING TREES, SET PLOW SHARE AND PLOW POINT AND LONG
STONE ON TOP, 3' NORTH AND 1' EAST OF ANCHOR POST.

STATE HIGHWAY DEPT. 1966, FOUND LARGE STONE WITH PLOW SHARE
AND PLOW POINT BESIDE, RAISED WITH "T" IRON FENCE POST

DONALD DAVIS, P.S. #17617, 1976, BOUNDARY SURVEY IN NORTHWEST 1/4
OF SECTION 11 INDICATES "T" IRON WITH TWO WITNESSES SAME AS STATE
HIGHWAY DEPARTMENT.

B. Description of corner evidence found and/or method applied in restoring or reestablishing corner:


FOUND CALHOUN COUNTY REMONUMENTATION MONUMENT P.S. 17617 (DONALD DAVIS)
NOT RECORDED, FOUND REMAINS OF OLD ANCHOR POST 3' SOUTH AND 1' WEST PER
A.H. CHASE 1909, FOUND STATE HIGHWAY DEPT. TAG IN 30" OAK EAST 18.78 FEET

LEFT EXISTING MONUMENT IN PLACE AND PLACED CARSONITE WITNESS POST 1.2' NORTH
AND 0.5' EAST OF MONUMENT.

C. Description of monument for corner and accessories established to perpetuate locating the position of the corner:

BERNTSEN MONUMENT AND CARSONITE WITNESS POST
30" OAK, EAST 18.87' (SET SPOTTER)
6" OAK, S60°W 14.31' (SET SPOTTER)
6" OAK, N54°W 22.03' (SET SPOTTER)
4" OAK, N04°E 11.13' (SET SPOTTER)
3' ± NORTH OF FALLEN E&W FENCE

AND IS ACCEPTED AS A CAREFUL AND FAITHFUL PERPETUATION OF THE POSITION OF THE ORIGINAL CORNER.

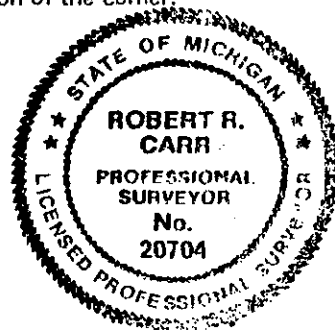

Signed by [Signature]

Date DECEMBER 9, 1998

Surveyor's Michigan License No. 20704 ROBERT R. CARR