

APPROVED

Date 7-27-94

CALHOUN COUNTY REMONUMENTATION.

For corners in

Calhoun

(County)

CALHOUN COUNTY REMONUMENTATION

LAND CORNER RECORDATION CERTIFICATE

Filing Requirement of Act 74, Mich. P.A. 1970

STATE OF MICHIGAN
CALHOUN COUNTY
RECORDED

28 JUL 94 11:13 A.M.

ANNE B. NORLANDER
CLERK - REGISTER OF DEEDS

1. Public Land Survey	T <u>1</u> S R <u>6</u> W	K-11
	T ___ R ___	_____
	T ___ R ___	_____
	T ___ R ___	_____
2. Property Controlling in Section	S ___ T ___ R ___	_____
	S ___ T ___ R ___	_____
3. Miscellaneous Property in Sec.	S ___ T ___ R ___	_____
	S ___ T ___ R ___	_____

Register of Deeds Stamp & File Number

- 4. Lot No. _____, Recorded Plat _____
- 5. Private Claims _____

I, Donald J. Davis, in a field survey on July 7, 1994, do hereby certify that under requirements of P.A. 74, Michigan P.A. of 1970, the corner points mentioned in lines 1 and 2 above were in conformance with regulations and rules therefore as required in the current manual of survey instructions of the United States Department of the Interior, Bureau of Land Management or by a decree of a Court of Law and/or that the corner points mentioned in lines 3, 4 and 5 above were in conformance with the rules of the Michigan Board of Land Surveyors or by a Decree of a Court of Law; established, re-established, monumented, re-monumented, recovered, found as expressed below:

NOTE: Not more than 4 corners, all in the same town and range, may be recorded on this certificate.

A	B	C	D	E	F	G	H	I	J	K	L	M
2	6	5	4	3	2	1						
3												
4	7	8	9	10	11	12						
5												
6	18	17	16	15	14	13						
7												
8	19	20	21	22	23	24						
9												
10	30	29	28	27	26	25						
11												
12	31	32	33	34	35	36						
13												

A. Description of original monument and accessories and/or subsequent restoration:

1825, Lyon	1973, J. King, Dekeyser & Assoc.
Set Post	5/8" iron
7" White Oak S 78° W 17 Links	3" Pine N 05° W 32.80'
6" White Oak N 5° W 47 links	Utility Pole S 60° E 45.37'
	14" Hickory S 55° W 72.68'
	Recorded in Liber 1039, page 441.

B. Description of corner evidence found and/or method applied in restoring or reestablishing corner:

Found 5/8" iron, checked with King witnesses.
Accepted as good local perpetuation of corner.

SURVEY & REMONUMENTATION


OCT 24 1994

COMMISSION

LIBER 1760 PAGE 640

C. Description of monument for corner and accessories established to perpetuate locating the position of the corner:

Set Berntsen monument and monument box.
4" Steel fence post South 28.65'
6" Steel fence post North 29.10'
16" Maple N 45° W 60.11'
Nail & Spotter 24" Hickory S 30° W 49.15'

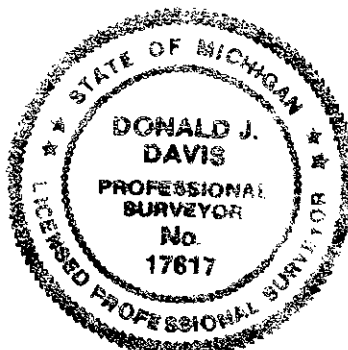

Signed by Donald J. Davis

Date July 25, 1994

Surveyor's Michigan License No. 17617