

1993

REMONUMENTATION

COMMISSION

LAND CORNER RECORDATION CERTIFICATE
Filing Requirement of Act 74, Mich. P.A. 1970

OCT 6 9 48 AM '93

CLERK-REGISTER
CALHOUN COUNTY, MICH.
ANNE B. HOHLANDER

For corners in
Calhoun

(County)

Located In:

Corner Code #

- 1. Public Land Survey T 1S R 6 W K-13
 T _____ R _____
 T _____ R _____
 T _____ R _____
- 2. Property Controlling S _____ T _____ R _____
 in Section S _____ T _____ R _____
- 3. Miscellaneous S _____ T _____ R _____
 Property in Sec. S _____ T _____ R _____
- 4. Lot No. _____, Recorded Plat _____
- 5. Private Claims _____

Register of Deeds Stamp & File Number

	A	B	C	D	E	F	G	H	I	J	K	L	M
2	6	5	4	3	2	1							
3													
4	7	8	9	10	11	12							
5													
6	18	17	16	15	14	13							
7													
8	19	20	21	22	23	24							
9													
10	30	29	28	27	26	25							
11													
12	31	32	33	34	35	36							
13													

I, Donald J. Davis, in a field survey on September 10, 1993, do hereby certify that under requirements of P.A. 74, Michigan P.A. of 1970, the corner points mentioned in lines 1 and 2 above were in conformance with regulations and rules therefore as required in the current manual of survey instructions of the United States Department of the Interior, Bureau of Land Management or by a decree of a Court of Law and/or that the corner points mentioned in lines 3, 4 and 5 above were in conformance with the rules of the Michigan Board of Land Surveyors or by a Decree of a Court of Law, established, re-established, monumented, re-monumented, recovered, found as expressed below:

NOTE: Not more than 4 corners, all in the same town and range, may be recorded on this certificate.

A. Description of original monument and accessories and/or subsequent restoration:

Corner set in original survey by Mullett in 1825.
16" Oak N 12° E 100 links.
9" Oak N 72° W 85 links. GONE
1" pipe in tile found by Corbit (MDSH) in 1966.
Pipe and tile recorded by DeKeyser 1973, Liber 1066, page 579.


B. Description of corner evidence found and/or method applied in restoring or reestablishing corner:

Found 1" pipe in tile from witnesses.
30" B. Oak N 57° W 45.47'.
10" Twin Oak N 10° E 29.74'.
SE corner house foundation N 42° W 112.75'.
Pipe accepted as corner as locally perpetuated and used for surveys in the area.

LIBER 15 PAGE 278

C. Description of monument for corner and accessories established to perpetuate locating the position of the corner:

Set Berntsen monument with brass cap in monument box in gravel road.
Nail and tag Twin 10" Oak N 20° E 28.80'.
Nail and tag Utility pole S 65° E 103.55'.
SE corner foundation of garage N 35° W 91.00'.
Nail and tag 34" Burr Oak N 57° W 45.47'.

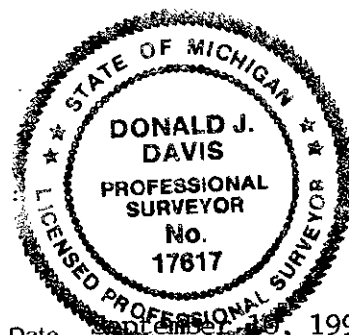

Signed by Donald J. Davis
Surveyor's Michigan License No. 17617

Date September 28, 1993