

Researched
8-16-93

FEB 22 1996

CALHOUN COUNTY REMONUMENTATION
LAND CORNER RECORDATION CERTIFICATE
Filing Requirement of Act 74, Mich. P.A. 1970

APPROVED *DJD*
Date SEPT 15 1993
CALHOUN COUNTY
REMONUMENTATION.

For corners in **COMMISSION**
Calhoun
(County)

	Located In:	Corner Code #
1. <u>Convis Twp.</u> Public Land Survey	T <u>1</u> S R <u>6</u> W	M-13
	T _____ R _____	_____
	T _____ R _____	_____
	T _____ R _____	_____
2. Property Controlling in Section	S _____ T _____ R _____	_____
	S _____ T _____ R _____	_____
3. Miscellaneous Property in Sec.	S _____ T _____ R _____	_____
	S _____ T _____ R _____	_____

STATE OF MICHIGAN
CALHOUN COUNTY
RECORDED
9 NOV 95 9:59 A.M.
ANNE B. NORLANDER
Register of Deeds Stamp & File Number

4. Lot No. _____, Recorded Plat _____
5. Private Claims _____

	A	B	C	D	E	F	G	H	I	J	K	L	M
2	6		5		4		3		2		1		
3													
4	7		8		9		10		11		12		
5													
6	18		17		16		15		14		13		
7													
8	19		20		21		22		23		24		
9													
10	30		29		28		27		26		25		
11													
12	31		32		33		34		35		36		
13													

Donald J. Davis, in a field survey on September 8, 1993, do hereby certify that under requirements of P.A. 74, Michigan P.A. of 1970, the corner points mentioned in lines 1 and 2 above were in conformance with regulations and rules therefore as required in the current manual of survey instructions of the United States Department of the Interior, Bureau of Land Management or by a decree of a Court of Law and/or that the corner points mentioned in lines 3, 4 and 5 above were in conformance with the rules of the Michigan Board of Land Surveyors or by a Decree of a Court of Law; established, re-established, monumented, re-monumented, recovered, found as expressed below:


NOTE: Not more than 4 corners, all in the same town and range, may be recorded on this certificate.

A. Description of original monument and accessories and/or subsequent restoration:
Tile set in resurvey of Marengo Township in 1825. Relocated in survey by Gifford in 1891.
10" Maple N 72° E 120 links.
12" Hickory N 74-3/4° W 190 links.

3. Description of corner evidence found and/or method applied in restoring or reestablishing corner:
Found 1 1/2" iron pipe in tile as set in resurvey. Recorded in 1974 in Liber 1039, page 442.
26" Maple N 55° E 61.59'
14" Hickory N 35° W 44.70'
Utility pole S 60° W 49.97'
Corner accepted as true corner as preserved by local surveyors.

LIBER 1830 PAGE 893

2. Description of monument for corner and accessories established to perpetuate locating the position of the corner:
Set Harrison monument in monument box in gravel road.
PK Nail 26" Maple N 55° E 61.35'
Nail & Tag 14" Hickory N 35° W 44.53'
PK Nail 28" Oak N 50° W 65.42'
West corner of house foundation S 40° E 106.50'

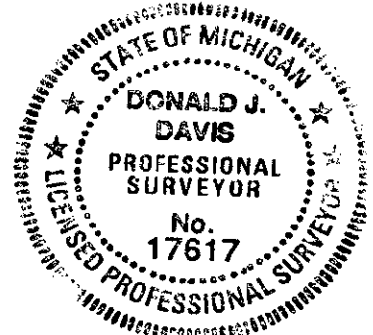

signed by Donald J. Davis
Surveyor's Michigan License No. 17617

Date November 7, 1995