

APPROVED

RECORDED

Date 3-16-94
CALHOUN COUNTY
REMONUMENTATION.

CALHOUN COUNTY REMONUMENTATION
LAND CORNER RECORDATION CERTIFICATE
Filing Requirement of Act 74, Mich. P.A. 1970

Mar 24 11 07 AM '94

For corners in CALHOUN (County)

Located In: _____ Corner Code --

1. Public Land Survey		<u>T 1S R 7W</u>	<u>A-1</u>
		<u>T 1S R 8W</u>	<u>M-1</u>
		T _____ R _____	_____
		T _____ R _____	_____
2. Property Controlling in Section	S _____	T _____ R _____	_____
	S _____	T _____ R _____	_____
3. Miscellaneous Property in Sec.	S _____	T _____ R _____	_____
	S _____	T _____ R _____	_____

CLERK-REGISTER
CALHOUN COUNTY, MICH.
ANNE B. NORLANDER
SURVEY &
REMONUMENTATION

OCT 27 1994

Register of Deeds Stamp & File Number

4. Lot No. _____, Recorded Plat _____

5. Private Claims _____

T1S R7W

	A	B	C	D	E	F	G	H	I	J	K	L	M
2	6	5	4	3	2								
3													
4	7	8	9	10	11	12							
5													
6	18	17	16	15	14	13							
7													
8	19	20	21	22	23	24							
9													
10	30	29	28	27	26	25							
11													
12	31	32	33	34	35	36							
13													

T1S R8W

I, BRIAN REYNOLDS, in a field survey on MARCH 8TH, 19 94, do hereby certify that under requirements of P.A. 74, Michigan P.A. of 1970, the corner points mentioned in lines 1 and 2 above were in conformance with regulations and rules therefore as required in the current manual of survey instructions of the United States Department of the Interior, Bureau of Land Management or by a decree of a Court of Law and/or that the corner points mentioned in lines 3, 4 and 5 above were in conformance with the rules of the Michigan Board of Land Surveyors or by a Decree of a Court of Law; established, re-established, monumented, re-monumented, recovered, found as expressed below:

NOTE: Not more than 4 corners, all in the same town and range, may be recorded on this certificate.

- A. Description of original monument and accessories and/or subsequent restoration:
- | | |
|---------------------------------|---|
| GENERAL LAND OFFICE | RESURVEY BY GIFFORD 1891 |
| 78.50 INTERSECT BASE LINE | Y. OAK 16" N13E 58 LKS |
| EAST OF POST T1N RANGE 7&8 WEST | W. OAK 30" S 28 1/2W 21 LKS |
| W. OAK 18 N31W 21 | |
| Do 10 S76E 52 | CHASE, DeKEYSER AND ALDEN FOR CONSUMER'S POWER COMPANY C. 1965 FOUND TILE WITH IRON ABOVE, 2' EAST OF FENCE SOUTH & IN C/L OF GRAVEL ROAD E & W |
| JOHN MULLETT DEC. 14, 1825 | 6" OAK N75°W 68.2' |
| | 12" OAK N70°E 85.1' |
| | 12" OAK S80°E 183.8' |

B. Description of corner evidence found and/or method applied in restoring or reestablishing corner:


ROAD HAS BEEN REBUILT SINCE CONSUMERS POWER CO. SURVEY, GRADE IS SEVERAL FEET LOWER, LEAVING NO POSSIBILITY OF RECOVERY OF TILE. ONE WITNESS TREE REMAINS, VIS. OAK S80°E 183.8' NOW MUCH LARGER. FOUND A-13 AND B-13 OF T1N, R7W. ALSO FOUND M-2 AND "N1/8 CORNER ON E LINE OF SECTION 1 "T1S R8W AS DESCRIBED BY CONSUMER'S POWER SURVEY, AND CORRESPONDING CLOSING CORNERS. PROJECTED LINE THROUGH TO INTERSECT BASE LINE, INTERSECT POINT FELL 0.04' WEST OF PRORATED GOVERNMENT JOG. SET STANDARD CALHOUN COUNTY MONUMENT AND MONUMENT BOX AT INTERSECTION, POINT FITS WITH REMAINING WITNESS TREE FOR BEARING AND DISTANCE.

LIBER 1738 PAGE 167

C. Description of monument for corner and accessories established to perpetuate locating the position of the corner:

WITNESSES TO STANDARD CALHOUN COUNTY MONUMENT IN CASTING

- NAIL & WITNESS TAG N. SIDE 10" OAK S80E 181.77
- NAIL & WITNESS TAG N'LY SIDE 15" OAK S65E 97.97
- NAIL NW SIDE UTILITY POLE S25W 50.93
- NAIL & WITNESS TAG IN W SIDE 15" MAPLE S20E 59.34
- NAIL & WITNESS TAG S. SIDE UTILITY POLE N70W 83.14
- NW CORNER FRAME GARAGE S70W 192.23

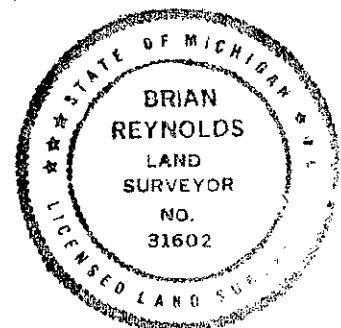

Signed by [Signature]

Date MARCH 15, 1994

Surveyor's Michigan License No. 31602