

APPROVED

Date 12-16-97 RRC CALHOUN COUNTY REMONUMENTATION
 CALHOUN COUNTY LAND CORNER RECORDATION CERTIFICATE
 DEMONUMENTATION. Filing Requirement of Act 74, Mich. P.A. 1970

STATE OF MICHIGAN
 CALHOUN COUNTY
 RECORDED

For corners in

<u>CALHOUN</u>	Located In:	Corner Code #
(County)		
PENNFIELD TOWNSHIP		
1. Public Land Survey	T <u>15</u> R <u>7W</u>	C-1
	T _____ R _____	_____
	T _____ R _____	_____
	T _____ R _____	_____
2. Property Controlling in Section	S _____ T _____ R _____	_____
	S _____ T _____ R _____	_____
3. Miscellaneous Property in Sec.	S _____ T _____ R _____	_____
	S _____ T _____ R _____	_____
4. Lot No. _____, Recorded Plat _____		
5. Private Claims _____		

19 DEC 97 2:39 P.M.

ANNE B. NORLANDER
 CLERK - REGISTER OF DEEDS

LIBER 1985 PAGE 529

BK 4 Pg 69

Register of Deeds Stamp & File Number

I, ROBERT R. CARR, in a field survey on DECEMBER 3, 19 97 do hereby state that under requirements of P.A. 74, Michigan P.A. of 1970, the corner points mentioned in lines 1 and 2 above were in conformance with regulations and rules therefore as required in the current manual of survey instructions of the United States Department of the Interior, Bureau of Land Management or by a decree of a Court of Law and /or that the corner points mentioned in lines 3, 4 and 5 above were in conformance with the rules of the Michigan Board of Land Surveyors or by a Decree of a Court of Law; established, re-established, monumented, recovered, found as expressed below:

NOTE: Not more than 2 corners, all in the same town and range, may be recorded on this certificate.

NORTHWEST CORNER, SECTION 5

A. Description of original monument and accessories and/or subsequent restoration:

- 1826 SLYVESTER SIBLEY, D.S.; W.O. 11" S12°E 13 LKS, W.O. 10" S47°W 66LKS.
- 1891 J.M. GIFFORD, RESURVEY; FOUND BY RUNNING LINE BETWEEN SECTIONS 5 & 6, PUT POST AT INTERSECTION WITH BASE LINE, Y.O. 8" S5°E 33 LKS, HICKORY 6" S27°W 59 LKS.
- 1964 CORNER POST RESET BY DAVIS OF CHASE, DEKEYSER & ALDEN FOR CONSUMERS POWER SURVEY (3/4" IRON)
- 1973 3/4" IRON REWITNESSED BY DEKEYSER AND ASSOCIATES
- 1981 3/4" IRON REWITNESSED BY PIKE OF DEKEYSER AND ASSOCIATES.

	A	B	C	D	E	F	G	H	I	J	K	L	M
1			6										
2		6		5		4		3		2			1
3													
4		7		8		9		10		11			12
5													
6		18		17		16		15		14			13
7													
8		19		20		21		22		23			24
9													
10		30		29		28		27		26			25
11													
12		31		32		33		34		35			36
13													

LIBER 1990 PAGE 820

SURVEY & REMONUMENTATION

B. Description of corner evidence found and/or method applied in restoring or reestablishing corner:

APR 07 1998


GLO AND RESURVEY WITNESSES ARE GONE.
 FOUND 3/4" IRON MATCHING WITNESSES FROM CHASE, DEKEYSER & ALDEN AND DEKEYSER AND ASSOCIATES.
 RAN TRAVERSE FROM SOUTH 1/4 POST OF SECTION 32, T.1N., R.7W. TO SOUTHWEST CORNER OF SECTION 32 AND FOUND 3/4" IRON TO BE 1.15 FEET SOUTH OF BASELINE.

ESTABLISHED CORNER LOCATION ON BASE LINE 1.15 FEET NORTH OF FOUND 3/4" IRON AND PLACED BERNTSEN MONUMENT IN MONUMENT BOX 0.6 FEET BELOW GRAVEL SURFACE AT EDGE OF BITUMINOUS PAVEMENT.

C. Description of monument for corner and accessories established to perpetuate locating the position of the corner:

- BERNTSEN MONUMENT IN MONUMENT BOX 0.6 FEET BELOW SURFACE OF GRAVEL SHOULDER.
- SET SPOTTER IN 7" WALNUT, S40°E 56.15 FEET
- SET SPOTTER IN 5" OAK, S50°W 40.18 FEET
- SET SPOTTER IN 18" OAK, N12°W 47.63 FEET
- SET SPOTTER IN 20" OAK, N50°E 72.80 FEET
- SET SPOTTER IN 10" HICKORY, S89°W 52.18 FEET
- 3/4" IRON, SOUTH 1.15 FEET.

STATE OF MICHIGAN
 CALHOUN COUNTY
 ANNE B. NORLANDER
 CLERK - REGISTER OF DEEDS
 13 JAN 98 2:01 A.M.
 RECORDED

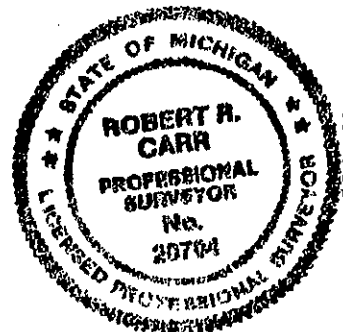

Signed by [Signature]
 Surveyor's Michigan License No. 20704

Date 12-15-97

This document is being re-recorded to reflect correct Town number.