SURVEY & REMONUMENTATION

1993

COMMISSION

CALHOUN COUNTY

REMONUMENTATION

LAND CORNER RECORDATION CERTIFICATE

Filing Requirement of Act 74, Mich. P.A. 1970

SEP 1 10 33 AM 93

CLERK-REGISTER
CALHOUN COUNTY, MICH.
ANNE B. NORLANDER

RECORDED

Register of Deeds Stamp & File Number

or corners in
CALHOUN
(County)

	Located In:	Corner Code #
. Public Land Survey	T 1 S R 7 W	C-13
	T ___ R ___	
	T ___ R ___	
	T ___ R ___	
. Property Controlling	S ___ T ___ R ___	
in Section	S ___ T ___ R ___	
. Miscellaneous	S ___ T ___ R ___	
Property in Sec.	S ___ T ___ R ___	

. Lot No. _____, Recorded Plat _____

. Private Claims _____

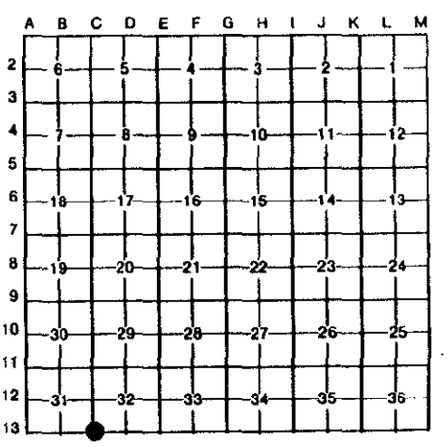

DONALD J. DAVIS, in a field survey on JULY 28, 19 93,

o hereby certify that under requirements of P.A. 74, Michigan P.A. of 1970, the corner points mentioned ı lines 1 and 2 above were in conformance with regulations and rules therefore as required in the ırrent manual of survey instructions of the United States Department of the Interior, Bureau of Land anagement or by a decree of a Court of Law and/or that the corner points mentioned in lines 3, 4 and 5 ɔove were in conformance with the rules of the Michigan Board of Land Surveyors or by a Decree of a ourt of Law; established, re-established, monumented, re-monumented, recovered, found as ‹pressed below:

OTE: Not more than 4 corners, all in the same town and range, may be recorded on this certificate.

. *Description of original monument and accessories and/or subsequent restoration:*

TILE SET IN RESURVEY OF 1891, BY GIFFORD.
SET AT GOVERNMENT DISTANCE WEST OF EMMETT TOWNSHIP CORNER (110 LINKS).
21" YELLOW OAK S 57½° E 62½ LINKS. GONE
10" WHITE OAK S 70¼° W 51 LINKS. GONE

. Description of corner evidence found and/or method applied in restoring or reestablishing corner:

FOUND SOLID CLAY TILE (3 SECTIONS) WITH 1" PIPE BESIDE.

THIS CORNER IS ACCEPTED AS A TRUE PERPETUATION OF THE ORIGINAL SURVEY CORNER.

. Description of monument for corner and accessories established to perpetuate locating the position of the corner:

REPLACED TILE WITH BERNSTEN STAINLESS STEEL MONUMENT WITH BRONZE CAP.
26" MAPLE N 12° E 65.72'.
30" WHITE OAK S 57° E 46.85'.
24" RED OAK S 10° W 15.60'.
SW CORNER HOUSE FOUNDATION N 50° W 36.70.

STATE OF MICHIGAN
DONALD J. DAVIS
PROFESSIONAL SURVEYOR
No. 17617
LICENSED PROFESSIONAL SURVEYOR

gned by Donald J. Davis Date August 12, 1993

urveyor's Michigan License No. 17617

FORM APPROVED BY MICHIGAN STATE BOARD OF LAND SURVEYORS, JAN. 26, 1971
REVISED MAY 14, 1975
REVISED JAN., 1983

LIBER 1700 PAGE 1[illegible]