

1993

COMMISSION

CALHOUN COUNTY  
REMONUMENTATION

LAND CORNER RECORDATION CERTIFICATE  
Filing Requirement of Act 74, Mich. P.A. 1970

For corners in  
CALHOUN

(County)

Located In:

Corner Code #/

1. Public Land Survey	T	1S	R	7W	D-10
	T		R		
	T		R		
	T		R		
2. Property Controlling in Section	S		T		R
	S		T		R
3. Miscellaneous Property in Sec.	S		T		R
	S		T		R

CLERK-REGISTER  
CALHOUN COUNTY, MICHIGAN  
ANNE G. NORLANDER

SEP 1 10 33 AM '93

RECORDED

Register of Deeds Stamp & File Number

4. Lot No. \_\_\_\_\_, Recorded Plat \_\_\_\_\_  
5. Private Claims \_\_\_\_\_

Donald J. Davis, in a field survey on JULY 16, 1993

to hereby certify that under requirements of P.A. 74, Michigan P.A. of 1970, the corner points mentioned in lines 1 and 2 above were in conformance with regulations and rules therefore as required in the current manual of survey instructions of the United States Department of the Interior, Bureau of Land Management or by a decree of a Court of Law and/or that the corner points mentioned in lines 3, 4 and 5 above were in conformance with the rules of the Michigan Board of Land Surveyors or by a Decree of a Court of Law, established, re-established, monumented, re-monumented, recovered, found as expressed below:

NOTE: Not more than 4 corners, all in the same town and range, may be recorded on this certificate.

A	B	C	D	E	F	G	H	I	J	K	L	M
2	6	5	4	3	2	1						
3												
4	7	8	9	10	11	12						
5												
6	18	17	16	15	14	13						
7												
8	19	20	21	22	23	24						
9												
10	30	29	28	27	26	25						
11												
12	31	32	33	34	35	36						
13												

6. Description of original monument and accessories and/or subsequent restoration:

- TILE SET IN RESURVEY IN 1891, BY GIFFORD.
- 8" WHITE OAK S 57° W 62 LINKS.
- 8" BURR OAK N 21° W 120 LINKS.
- 8" YELLOW OAK S 14° E 47 LINKS.


7. Description of corner evidence found and/or method applied in restoring or reestablishing corner:

- FOUND 5/8" IRON FROM WITNESSES.
- TILE DESTROYED BY ROAD CONSTRUCTION.
- 18" HICKORY N 80° E 111.22' GONE.
- 12" HICKORY S 75° W 76.67'
- UTILITY POLE S 70° W 66.34' MDSH.

THIS CORNER ACCEPTED AS A CAREFUL REESTABLISHMENT OF THE ORIGINAL CORNER.

8. Description of monument for corner and accessories established to perpetuate locating the position of the corner:

- SET BERNITSEN STAINLESS STEEL MONUMENT WITH BRONZE CAP IN MONUMENT BOX.
- UTILITY POLE S 72° W 66.33' NAIL & SPOTTER.
- 20" HICKORY S 76° W 97.20' NAIL & SPOTTER.
- 2" CORNER POST IN CONCRETE N 46° W 60.90' FACE OF POST.
- 22" OAK N 42° E 142.22' NAIL & SPOTTER.
- 18" OAK S 80° E 180.06' NAIL & SPOTTER.
- NW CORNER CONCRETE WELL COVER S 21° E 87.9'.

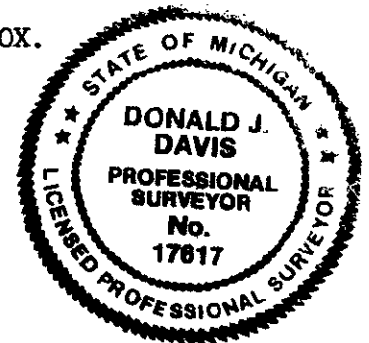

Signed by Donald J. Davis  
Surveyor's Michigan License No. 17617

Date August 12, 1993