

APPROVED

Date 11/25/97 RRC
**CALHOUN COUNTY
REMONUMENTATION.**

**CALHOUN COUNTY REMONUMENTATION
LAND CORNER RECORDATION CERTIFICATE**
Filing Requirement of Act 74, Mich. P.A. 1970

STATE OF MICHIGAN
CALHOUN COUNTY
RECORDED

1 DEC 97 4:50 P.M.

ANNE B. NORLANDER
CLERK - REGISTER OF DEEDS

LIBER 1980 PAGE 504

Register of Deeds Stamp & File Number

For corners in

<u>CALHOUN</u>	Located In:	Corner Code #
(County)		
PENNFIELD TOWNSHIP		
1. Public Land Survey	T <u>1S</u> R <u>7W</u>	<u>F-1</u>
	T _____ R _____	_____
	T _____ R _____	_____
	T _____ R _____	_____
2. Property Controlling	S _____ T _____ R _____	_____
in Section	S _____ T _____ R _____	_____
3. Miscellaneous	S _____ T _____ R _____	_____
Property in Sec.	S _____ T _____ R _____	_____

4. Lot No. _____, Recorded Plat _____
5. Private Claims _____

I, ROBERT R. CARR, in a field survey on APRIL 23, 1997 do hereby state that under requirements of P.A. 74, Michigan P.A. of 1970, the corner points mentioned in lines 1 and 2 above were in conformance with regulations and rules therefore as required in the current manual of survey instructions of the United States Department of the Interior, Bureau of Land Management or by a decree of a Court of Law and /or that the corner points mentioned in lines 3, 4 and 5 above were in conformance with the rules of the Michigan Board of Land Surveyors or by a Decree of a Court of Law; established, re-established, monumented, recovered, found as expressed below:

NOTE: Not more than 2 corners, all in the same town and range, may be recorded on this certificate.

A. Description of original monument and accessories and/or subsequent restoration:

THIS CORNER NOT SET BY G.L.O. SURVEY
1965 CONSUMER POWER COMPANY SURVEY; SET 5/8" IRON ON BASELINE 757.40 FEET WEST OF SOUTHEAST CORNER OF SECTION 33, ASSYRIA TOWNSHIP PER CONSUMER POWER COMPANY SURVEY.

	A	B	C	D	E	F	G	H	I	J	K	L	M
1													
2	6	5	4	3	2	1							
3													
4	7	8	9	10	11	12							
5													
6	18	17	16	15	14	13							
7													
8	19	20	21	22	23	24							
9													
10	30	29	28	27	26	25							
11													
12	31	32	33	34	35	36							
13													

B. Description of corner evidence found and/or method applied in restoring or reestablishing corner:


FOUND 1/2" IRON 10' ± WEST OF LOCATION CALLED FOR ON C.P.CO. SURVEY OF 1965.
DISREGARDED 1/2" IRON AND SET BERNTSEN MONUMENT IN MONUMENT BOX ON BASELINE 757.40 FEET WEST OF SE CORNER OF SECTION 33, ASSYRIA TOWNSHIP PER CONSUMER POWER SURVEY.

C. Description of monument for corner and accessories established to perpetuate locating the position of the corner:

BERNTSEN MONUMENT IN MONUMENT BOX
SET SPOTTER IN 18" OAK, N60°E 57.61 FEET
SET SPOTTER IN 30" OAK, S74-1/2°W 66.67 FEET
SET SPOTTER IN TWIN 28" OAK, N14°W, 29.81 FEET
SET SPOTTER IN 16" ELM, S34°E 32.67 FEET
SET SPOTTER IN 10" OAK, S40°W, 67.90 FEET.

SURVEY &
REMONUMENTATION

APR 07 1998

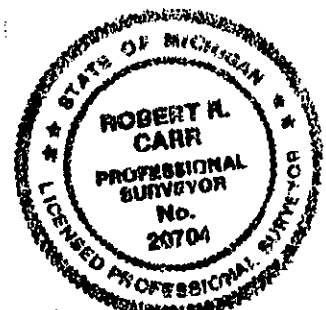

Signed by [Signature] SECTION _____ Date 11/24/97
Surveyor's Michigan License No. 20704