

**SURVEY &
REMONUMENTATION**

APR 26 1995

APPROVED

ate 10-19-94
**CALHOUN COUNTY
REMONUMENTATION.**

**COMMISSION
CALHOUN COUNTY REMONUMENTATION
LAND CORNER RECORDATION CERTIFICATE
Filing Requirement of Act 74, Mich. P.A. 1970**

For corners in

<u>CALHOUN</u> (County)	Located In:	Corner Code ##
PENNFIELD TWP		
1. Public Land Survey	T <u>1</u> S R <u>7</u> W	<u>G-4</u>
	T _____ R _____	_____
	T _____ R _____	_____
	T _____ R _____	_____
2. Property Controlling in Section	S _____ T _____ R _____	_____
	S _____ T _____ R _____	_____
3. Miscellaneous Property in Sec.	S _____ T _____ R _____	_____
	S _____ T _____ R _____	_____
4. Lot No. _____, Recorded Plat _____		
5. Private Claims _____		

STATE OF MICHIGAN
CALHOUN COUNTY
RECORDED

25 OCT 94 9:03 A.M.

ANNE B. NORLANDER
CLERK - REGISTER OF DEEDS

Register of Deeds Stamp & File Number

I, ROBERT R. CARR, in a field survey on JULY 15, 19 94, do hereby certify that under requirements of P.A. 74, Michigan P.A. of 1970, the corner points mentioned in lines 1 and 2 above were in conformance with regulations and rules therefore as required in the current manual of survey instructions of the United States Department of the Interior, Bureau of Land Management or by a decree of a Court of Law and/or that the corner points mentioned in lines 3, 4 and 5 above were in conformance with the rules of the Michigan Board of Land Surveyors or by a Decree of a Court of Law; established, re-established, monumented, re-monumented, recovered, found as expressed below:

NOTE: Not more than 4 corners, all in the same town and range, may be recorded on this certificate.

	A	B	C	D	E	F	G	H	I	J	K	L	M
2	6	5	4	3	2	1							
3													
4	7	8	9	10	11	12							
5													
6	18	17	16	15	14	13							
7													
8	19	20	21	22	23	24							
9													
10	30	29	28	27	26	25							
11													
12	31	32	33	34	35	36							
13													

A. Description of original monument and accessories and/or subsequent restoration:

ORIGINAL CORNER SET BY D.S. JOHN MULLETT 1825.
RE-SURVEY CORNER SET BY C.S.J.M. GIFFORD 1891.
FOUND STUMP OF ONE BEARING TREE, TOOK COURSE & DISTANCE AND SET POST IN ANGLE OF STONE WALL
W.O. 24" N73-1/2°W 102 LKS
W.O. 14" N88°E 38 LKS.


B. Description of corner evidence found and/or method applied in restoring or reestablishing corner:

FOUND SOLID TILE WITH CROSS OVER HOLLOW TILE AT ANGLE OF STONE ROWS AND INTERSECTION OF NORTH/SOUTH & EAST/WEST FENCES.
FOUND RE-SURVEY BEARING TREE (W.O. 14" N88°E 38 LKS) NOW 50".
REMOVED SOLID TILE AND PLACED BERNTSEN MONUMENT OVER HOLLOW TILE.

LIBER 1773 PAGE 890

C. Description of monument for corner and accessories established to perpetuate locating the position of the corner:

BERNTSEN MONUMENT OVER HOLLOW TILE
NAIL & SPOTTER IN SOUTH SIDE OF 50" OAK S88°E 24.76 FT.
NAIL & SPOTTER IN NORTHERLY SIDE OF 18" HICKORY N71°W 6.85 FTL
NAIL & SPOTTER IN EASTERLY SIDE OF 10" ASH N37°E 16.71 FT.
NAIL & SPOTTER IN WEST SIDE OF 14" MAPLE S9°W 37.85 FT.
4" STEEL FENCE POST IN CONCRETE WEST 0.96 FEET

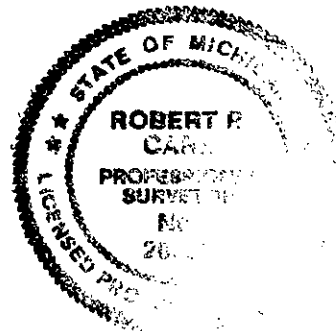

Signed by Robert R. Carr
Surveyor's Michigan License No. 20704

Date OCTOBER 19, 1994