

**SURVEY &  
REMONUMENTATION**

APR 26 1995

**APPROVED**

**COMMISSION**

Date 10-19-94  
**CALHOUN COUNTY  
REMONUMENTATION.**

**CALHOUN COUNTY REMONUMENTATION  
LAND CORNER RECORDATION CERTIFICATE  
Filing Requirement of Act 74, Mich. P.A. 1970**

For corners in

CALHOUN (County)	Located In:	Corner Code #
PENNFIELD TWP		
1. Public Land Survey	T <u>1 S</u> R <u>7 W</u>	<u>G-5</u>
	T _____ R _____	_____
	T _____ R _____	_____
	T _____ R _____	_____
2. Property Controlling in Section	S _____ T _____ R _____	_____
	S _____ T _____ R _____	_____
3. Miscellaneous Property in Sec.	S _____ T _____ R _____	_____
	S _____ T _____ R _____	_____
4. Lot No. _____, Recorded Plat _____		
5. Private Claims _____		

STATE OF MICHIGAN  
CALHOUN COUNTY  
RECORDED

25 OCT 94 9:04 A.M.

Register of Deeds Stamp & File Number  
CLERK - REGISTER OF DEEDS

I, ROBERT R. CARR, in a field survey on MAY 9, 19 94, do hereby certify that under requirements of P.A. 74, Michigan P.A. of 1970, the corner points mentioned in lines 1 and 2 above were in conformance with regulations and rules therefore as required in the current manual of survey instructions of the United States Department of the Interior, Bureau of Land Management or by a decree of a Court of Law and/or that the corner points mentioned in lines 3, 4 and 5 above were in conformance with the rules of the Michigan Board of Land Surveyors or by a Decree of a Court of Law; established, re-established, monumented, re-monumented, recovered, found as expressed below:

**NOTE: Not more than 4 corners, all in the same town and range, may be recorded on this certificate.**

	A	B	C	D	E	F	G	H	I	J	K	L	M
2	6	5	4	3	2	1							
3													
4	7	8	9	10	11	12							
5													
6	18	17	16	15	14	13							
7													
8	19	20	21	22	23	24							
9													
10	30	29	28	27	26	25							
11													
12	31	32	33	34	35	36							
13													

**A. Description of original monument and accessories and/or subsequent restoration:**

ORIGINAL CORNER SET BY D.S. JOHN MULLETT 1825.  
RE-SURVEY CORNER SET BY C.S. J. M. GIFFORD 1891.  
FOUND STUMP OF ONE BEARING TREE AND STONE SET FOR CORNER  
SET POST: Y.O. 10" N27°E 30 LKS Y.O. 10" N58°W 59 LKS


**B. Description of corner evidence found and/or method applied in restoring or reestablishing corner:**

FOUND SOLID TILE WITH CROSS OVER 2 HOLLOW TILES WITH POINTED STONE AND 1/2" IRON BESIDE.  
LEFT BOTTOM TILE IN PLACE AND REPLACED TOP TWO TILES WITH BERTSEN MONUMENT.

LIBER 1773 PAGE 891

**C. Description of monument for corner and accessories established to perpetuate locating the position of the corner:**

BERNTSEN MONUMENT OVER HOLLOW TILE, POINTED STONE AND CARSENITE WITNESS POST BESIDE.  
NAIL & SPOTTER IN EAST SIDE OF 12" CHERRY N07°W 6.16 FT.  
NAIL & SPOTTER IN SOUTHERLY SIDE OF 8" OAK S36°E 17.92 FT.  
NAIL & SPOTTER IN WEST SIDE OF 12" OAK SOUTH 24.12 FT.  
NAIL & SPOTTER IN NORTH SIDE OF 8" & 14" TWIN MAPLE N75°W 16.38 FT.

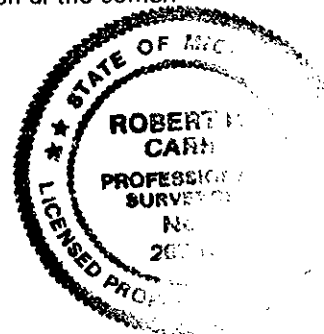

Signed by Robert R. Carr  
ROBERT R. CARR  
Surveyor's Michigan License No. 20704

Date OCTOBER 19, 1994