

**APPROVED**  
 Date 11-12-96  
**CALHOUN COUNTY**  
**REMONUMENTATION.**

**CALHOUN COUNTY REMONUMENTATION**  
**LAND CORNER RECORDATION CERTIFICATE**  
 Filing Requirement of Act 74, Mich. P.A. 1970

STATE OF MICHIGAN  
 CALHOUN COUNTY  
 RECORDED

19 FEB 97 3:50 P.M.

ANNE B. NORLANDER  
 CLERK - REGISTER OF DEEDS

LIBER 1916 PAGE 113

Register of Deeds Stamp & File Number

<u>Calhoun</u> <small>(County)</small>	Located In:	Corner Code #
<u>Pennfield Twp</u>		
1. Public Land Survey Sec 34	T <u>1</u> S R <u>7</u> W	<u>H-13</u>
	T _____ R _____	_____
	T _____ R _____	_____
	T _____ R _____	_____
2. Property Controlling In Section	S _____ T _____ R _____	_____
	S _____ T _____ R _____	_____
3. Miscellaneous Property in Sec.	S _____ T _____ R _____	_____
	S _____ T _____ R _____	_____
4. Lot No. _____, Recorded Plat _____		
5. Private Claims _____		

I, Robert R. Carr, in a field survey on October 28, 19 96, do hereby certify that under requirements of P.A. 74, Michigan P.A. of 1970, the corner points mentioned in lines 1 and 2 above were in conformance with regulations and rules therefore as required in the current manual of survey instructions of the United States Department of the Interior, Bureau of Land Management or by a decree of a Court of Law and/or that the corner points mentioned in lines 3, 4 and 5 above were in conformance with the rules of the Michigan Board of Land Surveyors or by a Decree of a Court of Law; established, re-established, monumented, re-monumented, recovered, found as expressed below:

**NOTE: Not more than 4 corners, all in the same town and range, may be recorded on this certificate.**

A. Description of original monument and accessories and/or subsequent restoration:

G.L.O. S. Sibley 1826

Resurvey; Gifford 1891, found stump of one Government bearing tree & corner kept by

Mr. Palmiter, set post (tile).

1948 witnesses no name or date

12" Hickory S65°W 18.5 ft.

Twin Hickory S35°E 13.1 ft.

I.P. West 7.26 feet; RR tie end post West 6.0 ft.

B. Description of corner evidence found and/or method applied in restoring or reestablishing corner:

Found hollow tile set in stones and broken glass with a solid tile laying on East side, iron pipe marking N 1/4 Section 3 Emmett Twp West 7.26' (average of GLO jogs at NE & NW corners of Section 3 Emmett).

Found stump of twin Hickory and RR tie post from 1948 witnesses still in place, distances & bearings checked.

Accepted hollow tile as true perpetuation of corner.

C. Description of monument for corner and accessories established to perpetuate locating the position of the corner:

Replaced hollow tile with Berntsen Calhoun County Remonumentation Monument and Carsinite witness post.

Nail & spotter Westerly side 10" Cherry S21°E 22.72 feet.

Nail & spotter Southerly side 8" Hickory S80°E 34.13 feet.

Nail & spotter Easterly side 8" Hickory N06°W 17.59 feet;


Nail & spotter Northwesterly side 14" Hickory S47°W 41.43 feet.

	A	B	C	D	E	F	G	H	I	J	K	L	M
2	6		5		4		3		2				
3													
4	7		8		9		10		11		12		
5													
6	18		17		16		15		14		13		
7													
8	19		20		21		22		23		24		
9													
10	30		29		28		27		26		25		
11													
12	31		32		33		34		35		36		
13													

Pennfield Township

SURVEY &  
 REMONUMENTATION

Signed by Robert R. Carr APR 07 1998 Date February 14, 1997  
 Surveyor's Michigan License No. 20704

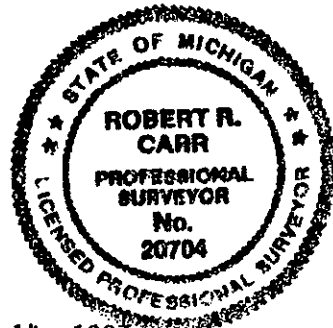

SECTION