

**SURVEY &
REMONUMENTATION**

APR 26 1995

APPROVED

ite 12-19-94
**CALHOUN COUNTY
REMONUMENTATION.**
For corners in

**COMMISSION
CALHOUN COUNTY REMONUMENTATION
LAND CORNER RECORDATION CERTIFICATE
Filing Requirement of Act 74, Mich. P.A. 1970**

<u>CALHOUN</u> (County)	Located In:	Corner Code #:
PENNFIELD TWP.	T 1 S R 7 W	J-9
1. Public Land Survey	T _____ R _____	_____
	T _____ R _____	_____
	T _____ R _____	_____
	T _____ R _____	_____
2. Property Controlling in Section	S _____ T _____ R _____	_____
	S _____ T _____ R _____	_____
3. Miscellaneous Property in Sec.	S _____ T _____ R _____	_____
	S _____ T _____ R _____	_____
4. Lot No. _____, Recorded Plat _____		
5. Private Claims _____		

STATE OF MICHIGAN
CALHOUN COUNTY
RECORDED

25 OCT 94 9:04 A.M.

ANNE B. NORLANDER
CLERK - REGISTER OF DEEDS
Register of Deeds Stamp & File Number

	A	B	C	D	E	F	G	H	I	J	K	L	M
2	6	5	4	3	2	1							
3													
4	7	8	9	10	11	12							
5													
6	18	17	16	15	14	13							
7													
8	19	20	21	22	23	24							
9													
10	30	29	28	27	26	25							
11													
12	31	32	33	34	35	36							
13													

I, ROBERT R. CARR, in a field survey on MAY 9, 1994, do hereby certify that under requirements of P.A. 74, Michigan P.A. of 1970, the corner points mentioned in lines 1 and 2 above were in conformance with regulations and rules therefore as required in the current manual of survey instructions of the United States Department of the Interior, Bureau of Land Management or by a decree of a Court of Law and/or that the corner points mentioned in lines 3, 4 and 5 above were in conformance with the rules of the Michigan Board of Land Surveyors or by a Decree of a Court of Law; established, re-established, monumented, re-monumented, recovered, found as expressed below:

NOTE: Not more than 4 corners, all in the same town and range, may be recorded on this certificate.

A. Description of original monument and accessories and/or subsequent restoration:

ORIGINAL CORNER SET BY D.S. MULLETT 1825.
RE-SURVEY CORNER SET BY C.S.J.M. GIFFORD 1891.
FOUND STAKE KEPT FOR CORNER AT INTERSECTION OF 1/4 LINE FENCE WITH SECTION LINE.
SET POST FROM WHICH Y.O. 10" N71°E 12 LKS.
HICKORY 6" N48°E 29 LKS.


B. Description of corner evidence found and/or method applied in restoring or reestablishing corner:

FOUND TILE 1'± SOUTH OF RAIL ROAD RAIL FENCE POST.
REPLACED TILE WITH BERNTSEN MONUMENT.

C. Description of monument for corner and accessories established to perpetuate locating the position of the corner:

BERNTSEN MONUMENT.
1.06' SOUTH OF RAIL ROAD RAIL FENCE CORNER POST.
NAIL & SPOTTER IN SOUTHERLY SIDE OF 38" OAK N57°E 9.03 FT.
NAIL & SPOTTER IN WESTERLY SIDE OF 30" OAK S17°E 59.65 FT.
NAIL & SPOTTER IN NORTHERLY SIDE OF 14" OAK S41°W 6.46 FT.
NAIL & SPOTTER IN NORTHERLY SIDE OF 12" HICKORY N81°W 30.66 FT.

LIBER 1773 PAGE 893

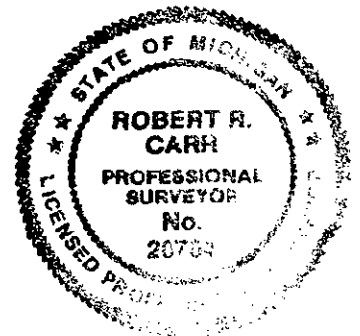

Signed by *Robert R. Carr*
ROBERT R. CARR
Surveyor's Michigan License No. 20704

Date OCTOBER 19, 1994