

**SURVEY &  
REMONUMENTATION**

APR 26 1995

**APPROVED**

Date 10-19-94  
**CALHOUN COUNTY  
REMONUMENTATION.**

**COMMISSION  
CALHOUN COUNTY REMONUMENTATION  
LAND CORNER RECORDATION CERTIFICATE  
Filing Requirement of Act 74, Mich. P.A. 1970**

For corners in

<u>CALHOUN</u> (County)	Located In:	Corner Code #
PENNFIELD TWP		
1. Public Land Survey	T <u>1</u> S R <u>7</u> W	K-8
	T _____ R _____	_____
	T _____ R _____	_____
	T _____ R _____	_____
2. Property Controlling in Section	S _____ T _____ R _____	_____
	S _____ T _____ R _____	_____
3. Miscellaneous Property in Sec.	S _____ T _____ R _____	_____
	S _____ T _____ R _____	_____

STATE OF MICHIGAN  
CALHOUN COUNTY  
RECORDED

25 OCT 94 9:04 A.M.

Register of Deeds Stamp & File Number  
CLERK REGISTER OF DEEDS

4. Lot No. \_\_\_\_\_, Recorded Plat \_\_\_\_\_  
5. Private Claims \_\_\_\_\_

	A	B	C	D	E	F	G	H	I	J	K	L	M
2	6	5	4	3	2	1							
3													
4	7	8	9	10	11	12							
5													
6	18	17	16	15	14	13							
7													
8	19	20	21	22	23	24							
9													
10	30	29	28	27	26	25							
11													
12	31	32	33	34	35	36							
13													

I, ROBERT R. CARR, in a field survey on MAY 9, 1994, do hereby certify that under requirements of P.A. 74, Michigan P.A. of 1970, the corner points mentioned in lines 1 and 2 above were in conformance with regulations and rules therefore as required in the current manual of survey instructions of the United States Department of the Interior, Bureau of Land Management or by a decree of a Court of Law and/or that the corner points mentioned in lines 3, 4 and 5 above were in conformance with the rules of the Michigan Board of Land Surveyors or by a Decree of a Court of Law; established, re-established, monumented, re-monumented, recovered, found as expressed below:


**NOTE: Not more than 4 corners, all in the same town and range, may be recorded on this certificate.**

A. Description of original monument and accessories and/or subsequent restoration:  
ORIGINAL CORNER SET BY D.S. JOHN MULLETT 1825.  
RE-SURVEY CORNER SET BY C.S.J.M. GIFFORD 1891.  
FOUND STUMP OF W.O. BEARING TREE, RAN N21°E 230 LKS AND SET POST.  
W.O. 22" S1/2°W 162 LKS.

B. Description of corner evidence found and/or method applied in restoring or reestablishing corner:  
FOUND 3" SOLID TILE OVER TWO 3" HOLLOW TIELS SET IN STONES.  
ACCEPTED TILES AS RE-SURVEY CORNER BY GIFFORD.  
SET BERNTSEN MONUMENT OVER LOWER TILE AND PLACED STONES AROUND.

LIBER 1773 PAGE 892

C. Description of monument for corner and accessories established to perpetuate locating the position of the corner:  
BERNTSEN MONUMENT OVER TILE.  
NW CORNER OF BARN FOUNDATION N76°E 107.91 FT.  
NAIL & SPOTTER IN NORTHERLY SIDE OF 12" CHERRY S72°W 22.18 FT.  
NAIL & SPOTTER IN NORTHERLY SIDE OF CLUMP OF 8", 12" TO 24" MAPLES N78°W 49.23 FT.  
NAIL & SPOTTER IN NORTHWESTERLY SIDE OF 8" CHERRY S30°W 52.40 FT.

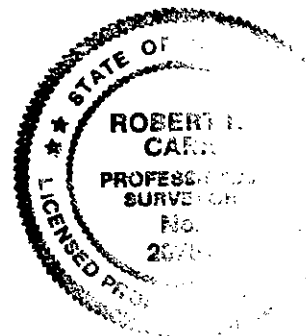

Signed by Robert R. Carr  
Surveyor's Michigan License No. 20704

Date OCTOBER 19, 1994