

APPROVED

Date 12-16-97 *RRC*
CALHOUN COUNTY
REMONUMENTATION.

**CALHOUN COUNTY REMONUMENTATION
LAND CORNER RECORDATION CERTIFICATE**
Filing Requirement of Act 74, Mich. P.A. 1970

STATE OF MICHIGAN
CALHOUN COUNTY
RECORDED

For corners in

<u>CALHOUN</u>	Located In:	Corner Code #
(County)		
PENNFIELD TOWNSHIP		
1. Public Land Survey	T <u>1S</u> R <u>7W</u>	<u>M-9</u>
	T _____ R _____	_____
	T _____ R _____	_____
	T _____ R _____	_____
2. Property Controlling in Section	S _____ T _____ R _____	_____
	S _____ T _____ R _____	_____
3. Miscellaneous Property in Sec.	S _____ T _____ R _____	_____
	S _____ T _____ R _____	_____

19 DEC 97 2:39 P.M.

ANNE B. NORLANDER
CLERK - REGISTER OF DEEDS

LIBER **1985** PAGE **531**

Register of Deeds Stamp & File Number

4. Lot No. _____, Recorded Plat _____
5. Private Claims _____

I, ROBERT R. CARR, in a field survey on DECEMBER 9, 1997 do hereby state that under requirements of P.A. 74, Michigan P.A. of 1970, the corner points mentioned in lines 1 and 2 above were in conformance with regulations and rules therefore as required in the current manual of survey instructions of the United States Department of the Interior, Bureau of Land Management or by a decree of a Court of Law and /or that the corner points mentioned in lines 3, 4 and 5 above were in conformance with the rules of the Michigan Board of Land Surveyors or by a Decree of a Court of Law; established, re-established, monumented, recovered, found as expressed below:

NOTE: Not more than 2 corners, all in the same town and range, may be recorded on this certificate.

A. Description of original monument and accessories and/or subsequent restoration:

1826 SYLVESTER SIBLEY D.S. W.O. 10" S40°W 20 LKS, W.O. 10" N53°W 29 LKS
1891 GIFFORD, RESURVEY HICKORY 6" N10°W 22 LKS, W.O. 20" N4°W 20 LKS

B. Description of corner evidence found and/or method applied in restoring or reestablishing corner:


FOUND 3" SOLID TILE OVER 3" HOLLOW TILE IN BED OF STONES
50" STUMP OF RESURVEY BEARING TREE (W.O. 20" N4°W 20 LKS) IS N6°W±, 13 FEET TO CENTER
ACCEPTED TILE AS TRUE PERPETUATION OF ORIGINAL CORNER AND REPLACED TILE WITH BERNTSEN MONUMENT WITH CARSONITE WITNESS POST ON NORTH SIDE.

C. Description of monument for corner and accessories established to perpetuate locating the position of the corner:

BERNTSEN MONUMENT WITH CARSONITE WITNESS POST ON NORTH SIDE.
SET SPOTTER IN 6" MAPLE, N27°W 10.06 FEET
SET SPOTTER IN 4" CHERRY, N68°E 8.35 FEET
SET SPOTTER IN 5" OAK, S82°W 16.04 FEET
SET SPOTTER IN 6" HICKORY, N31°E 31.36 FEET.

SURVEY &
REMONUMENTATION

APR 07 1998

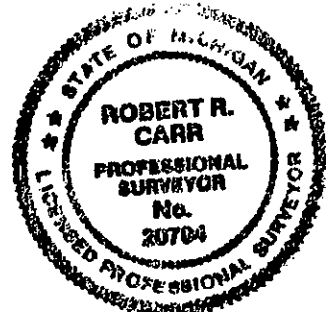

Signed by *Robert R. Carr* SECTION _____

Date 12-15-97

Surveyor's Michigan License No. 20704