

**SURVEY &
REMONUMENTATION**

APR 26 1995

APPROVED
Date 11-28-94
**CALHOUN COUNTY
REMONUMENTATION.**

COMMISSION
**CALHOUN COUNTY REMONUMENTATION
LAND CORNER RECORDATION CERTIFICATE**
Filing Requirement of Act 74, Mich. P.A. 1970

STATE OF MICHIGAN
CALHOUN COUNTY
RECORDED

29 NOV 94 10:23 A.M.

ANNE B. NORLANDER
CLERK - REGISTER OF DEEDS

CALHOUN (County)	Located In:	Corner Code #
PENNFIELD TWP	T _____ R _____	
1. Public Land Survey	T _____ R _____	<u>Other #2</u>
	T _____ R _____	
	T _____ R _____	
2. Property Controlling in Section	S <u>31</u> T 1 S R 7 W	<u>A-12</u>
	S _____ T _____ R _____	
3. Miscellaneous Property in Sec.	S _____ T _____ R _____	
	S _____ T _____ R _____	

Register of Deeds Stamp & File Number

4. Lot No. _____, Recorded Plat _____
5. Private Claims _____

	A	B	C	D	E	F	G	H	I	J	K	L
2	6		5		4		3		2		1	
3												
4	7		8		9		10		11		12	
5												
6	18		17		16		15		14		13	
7												
8	19		20		21		22		23		24	
9												
10	30		29		28		27		26		25	
11												
12	31		32		33		34		35		36	
13												

I, ROBERT R. CARR, in a field survey on NOVEMBER 22, 19 94, do hereby certify that under requirements of P.A. 74, Michigan P.A. of 1970, the corner points mentioned in lines 1 and 2 above were in conformance with regulations and rules therefore as required in the current manual of survey instructions of the United States Department of the Interior, Bureau of Land Management or by a decree of a Court of Law and/or that the corner points mentioned in lines 3, 4 and 5 above were in conformance with the rules of the Michigan Board of Land Surveyors or by a Decree of a Court of Law; established, re-established, monumented, re-monumented, recovered, found as expressed below:

NOTE: Not more than 4 corners, all in the same town and range, may be recorded on this certificate.

A. Description of original monument and accessories and/or subsequent restoration:

WITNESSES OLD, SOURCE UNKNOWN
13.86 FEET SOUTH OF BEDFORD CORNER
12.54 FEET NORTH OF CENTERLINE TOWERS.


B. Description of corner evidence found and/or method applied in restoring or reestablishing corner:

FOUND NORTHEAST CORNER SECTION 36 T1S R8W (BEDFORD CORNER).
MEASURED SOUTH AND DUG, FOUND 1"X12" IRON PIPE LYING DOWN, DUG TO DEPTH OF 3 FEET NO OTHER REMAINS OF CORNER FOUND.
SET BERNTSEN MONUMENT IN MONUMENT BOX ON TOWN LINE 13.86 FEET SOUTH OF BEDFORD CORNER AS PER OLD WITNESSES, WITNESS TO CENTERLINE TOWERS ALSO CHECKS GOOD.

LIBER 1778 PAGE 567

C. Description of monument for corner and accessories established to perpetuate locating the position of the corner:

BERNTSEN MONUMENT IN MONUMENT BOX
TOP NUT OF FIRE HYDRANT N50°W 69.94 FEET.
NORTHWEST LEG OF TRANSMISSION LINE TOWER AT FIRST HORIZONTAL BRACE ABOVE GROUND S75°E 50.24 FEET.
SOUTHWEST LEG OF TRANSMISSION LINE TOWER AT FIRST HORIZONTAL BRACE ABOVE GROUND S58°E 49.44 FEET.
NAIL & SPOTTER IN SOUTHEAST SIDE OF U-POLE N42°E 66.55 FEET.

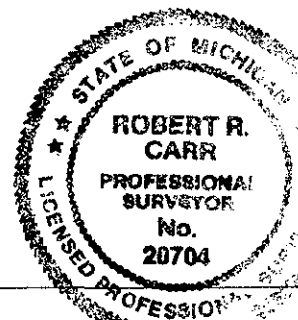

Signed by [Signature] Date NOVEMBER 28, 1994
Surveyor's Michigan License No. 20704