

APPROVED

Date 8-18-99 RRC
CALHOUN COUNTY
REMONUMENTATION.

CALHOUN COUNTY REMONUMENTATION
LAND CORNER RECORDATION CERTIFICATE
Filing Requirement of Act 74, Mich. P.A. 1970

STATE OF MICHIGAN
CALHOUN COUNTY
RECORDED

For corners in

20 AUG 1999 1:23:49 PM

<u>CALHOUN</u> (County)	Located In:	Corner Code #
BEDFORD TOWNSHIP		
1. Public Land Survey	<u>T 1S R 8W</u>	<u>A-1</u>
	T _____ R _____	_____
	T _____ R _____	_____
	T _____ R _____	_____
2. Property Controlling in Section	S _____ T _____ R _____	_____
	S _____ T _____ R _____	_____
3. Miscellaneous Property in Sec.	S _____ T _____ R _____	_____
	S _____ T _____ R _____	_____

WNE E. MURLANDER
CLERK - REGISTER OF DEEDS
LIBER 2154 PAGE 419

Register of Deeds Stamp & File Number

4. Lot No. _____, Recorded Plat _____
5. Private Claims _____

I, ROBERT R. CARR, in a field survey on AUGUST 2, 1999 do hereby state that under requirements of P.A. 74, Michigan P.A. of 1970, the corner points mentioned in lines 1 and 2 above were in conformance with regulations and rules therefore as required in the current manual of survey instructions of the United States Department of the Interior, Bureau of Land Management or by a decree of a Court of Law and /or that the corner points mentioned in lines 3, 4 and 5 above were in conformance with the rules of the Michigan Board of Land Surveyors or by a Decree of a Court of Law; established, re-established, monumented, recovered, found as expressed below:

1													
2	5	5	4	3	2	1							
3													
4	7	8	9	10	11	12							
5													
6	18	17	16	15	14	13							
7													
8	19	20	21	22	23	24							
9													
10	30	29	28	27	26	25							
11													
12	31	32	33	34	35	36							
13													

NOTE: Not more than 2 corners, all in the same town and range, may be recorded on this certificate.

A. Description of original monument and accessories and/or subsequent restoration:

G.L.O. CORNER SET BY JOHN MULLETT D.S. 1825
RESURVEY BY H.K. WHITNEY, 1900 FOUND CORNER FROM ONE U.S. BEARING TREE
INGERSOLL WATSON AND MCMACHEN, 1979 FOUND IRON ROD
ROBERT CARR P.S. 20704, FOUND 1/2" IRON ROD 1989

SURVEY &
REMONUMENTATION

MAR 18 2000

SECTION

B. Description of corner evidence found and/or method applied in restoring or reestablishing corner:


FOUND 1/2" IRON ROD MATCHING WITNESSES FROM CARR 1989 AND ONE WITNESS FROM MCMACHEN 1979
DUG FOR TILE BUT COULD NO FIND.
RAN BASELINE FROM A-13 TIN, R8W TO B-13TIN, R8W.
HELD EAST-WEST LOCATION OF FOUND 1/2" IRON AND SET CORNER ON BASELINE 0.9 FT NORTH OF FOUND 1/2" IRON.

C. Description of monument for corner and accessories established to perpetuate locating the position of the corner:

BERNTSEN MONUMENT WITH CARSONTIE WITNESS POST 1' ± SOUTH
TWIN 22"-16" OAK S 48°E 11.26' (NAIL AND SPOTTER)
28" OAK S 29°W 33.72' (NAIL AND SPOTTER)
10" OAK S 60°W 33.25' (NAIL AND SPOTTER)
6" HICKORY N 80°W 56.07' (NAIL AND SPOTTER)

THIS LOCATION IS ACCEPTED AS THE BEST AVAILABLE EVIDENCE OF THE POSITION OF THE ORIGINAL CORNER.

Signed by [Signature]
Surveyor's Michigan License No. 20704

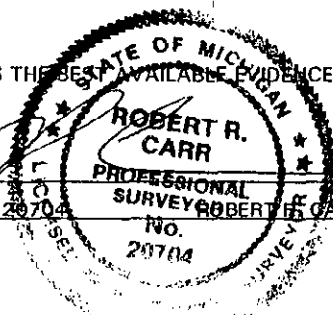

Date 8-18-99