

APPROVED

Date 11/25/97 RRC
**CALHOUN COUNTY
 REMONUMENTATION.**

**CALHOUN COUNTY REMONUMENTATION
 LAND CORNER RECORDATION CERTIFICATE**
 Filing Requirement of Act 74, Mich. P.A. 1970

STATE OF MICHIGAN
 CALHOUN COUNTY
 RECORDED

1 DEC 97 4:50 P.M.

ANNE B. NORLANDER
 CLERK - REGISTER OF DEEDS

LIBER **1980** PAGE **507**

Register of Deeds Stamp & File Number

For corners in

<u>CALHOUN</u>	Located In:	Corner Code #
(County)		
BEDFORD TOWNSHIP		
1. Public Land Survey	T <u>1S</u> R <u>8W</u>	<u>A-9</u>
	T _____ R _____	_____
	T _____ R _____	_____
	T _____ R _____	_____
2. Property Controlling	S _____ T _____ R _____	_____
in Section	S _____ T _____ R _____	_____
3. Miscellaneous	S _____ T _____ R _____	_____
Property in Sec.	S _____ T _____ R _____	_____

4. Lot No. _____, Recorded Plat _____
 5. Private Claims _____

I, ROBERT R. CARR, in a field survey on SEPTEMBER 29, 1997 do hereby state that under requirements of P.A. 74, Michigan P.A. of 1970, the corner points mentioned in lines 1 and 2 above were in conformance with regulations and rules therefore as required in the current manual of survey instructions of the United States Department of the Interior, Bureau of Land Management or by a decree of a Court of Law and/or that the corner points mentioned in lines 3, 4 and 5 above were in conformance with the rules of the Michigan Board of Land Surveyors or by a Decree of a Court of Law; established, re-established, monumented, recovered, found as expressed below:

NOTE: Not more than 2 corners, all in the same town and range, may be recorded on this certificate.

A. Description of original monument and accessories and/or subsequent restoration:

1826 SYLVESTER SIBLEY D.S. INTERSECTED WEST BOUNDARY 11LKS SOUTH OF POST, SET POST AT INTERSECTION FOR CORNER SECTIONS 19 & 30.
 1888 SETH PRATT, RESURVEY, PLACED POST (TILE) 11LKS SOUTH OF ROSS TOWNSHIP POST AS ESTABLISHED BY F. HODGMAN, B. ASH S5°E 17-1/2 LKS; SWAMP OAK 4" N22°W 8 LKS.
 1/15/93 L.C.R.C., JOHN F. KORR, JR. L. 1668, P. 964.
 6/22/93 L.C.R.C., JOHN F. KORR, JR., L. 1689, P. 842 (TO CORRECT L. 1668, P. 964.)

B. Description of corner evidence found and/or method applied in restoring or reestablishing corner:

FOUND 2" SOLID TILE 7.26 FEET (11 LKS) SOUTH OF CORNER TO SECTIONS 24 & 25, ROSS TOWNSHIP (KALAMAZOO COUNTY REMONUMENTATION)
 DID NOT FIND 1/2" REBAR CALLED FOR IN L.C.R.C. L. 1689, P. 842, BY JOHN F. KORR, JR.
 THIS L.C.R.C. APPEARS TO BE IN ERROR ALSO.
 ACCEPTED TILE AS TRUE PERPETUATION OF CORNER AND REPLACED WITH BERNTSEN MONUMENT.

C. Description of monument for corner and accessories established to perpetuate locating the position of the corner:


BERNTSEN MONUMENT WITH BRICKS AROUND AND CARSONITE WITNESS POST 0.6 FEET EAST.
 SET SPOTTER IN 9" ELM, N70°E 10.17 FEET
 SET SPOTTER IN 18" OAK, S88°W 55.67 FEET
 SET SPOTTER IN 10" ASH, S74°E 26.57 FEET
 SET SPOTTER IN 28" OAK, S41°W 87.94 FEET
 SET SPOTTER IN 8" ASH, N50°E 28.00 FEET

	A	B	C	D	E	F	G	H	I	J	K	L	M
1													
2	8		5		4		3		2		1		
3													
4	7		6		9		10		11		12		
5													
6	18		17		16		15		14		13		
7													
8	19		20		21		22		23		24		
9													
10	30		29		28		27		26		25		
11													
12	31		32		33		34		35		36		
13													

**SURVEY &
 REMONUMENTATION**

APR 07 1998

SECTION

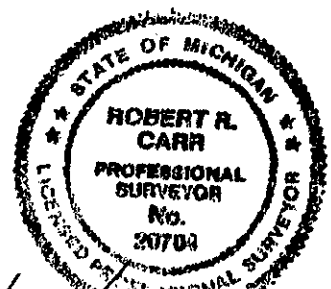

Signed by [Signature]
 Surveyor's Michigan License No. 20704

Date 11/24/97