

APPROVED

Date 10-21-97
CALHOUN COUNTY
REMONUMENTATION.

LAND CORNER RECORDATION CERTIFICATE
Filing Requirement of Act 74, Mich. P.A. 1970

STATE OF MICHIGAN
CALHOUN COUNTY
RECORDED

For corners in

24 OCT 97 12:01 P.M.

ANNE B. NORLANDER
CLERK - REGISTER OF DEEDS

LIBER 1973 PAGE 178

Register of Deeds Stamp & File Number

<u>CALHOUN</u> (County) BEDFORD	Located In:	Corner Code #
1. Public Land Survey	T <u>1S</u> R <u>8W</u>	<u>C-9</u>
	T _____ R _____	_____
	T _____ R _____	_____
	T _____ R _____	_____
2. Property Controlling in Section	S _____ T _____ R _____	_____
	S _____ T _____ R _____	_____
3. Miscellaneous Property in Sec.	S _____ T _____ R _____	_____
	S _____ T _____ R _____	_____
4. Lot No. _____, Recorded Plat _____		
5. Private Claims _____		

I, ROBERT R. CARR, in a field survey on SEPTEMBER 24, 1997 do hereby state that under requirements of P.A. 74, Michigan P.A. of 1970, the corner points mentioned in lines 1 and 2 above were in conformance with regulations and rules therefore as required in the current manual of survey instructions of the United States Department of the Interior, Bureau of Land Management or by a decree of a Court of Law and for that the corner points mentioned in lines 3, 4 and 5 above were in conformance with the rules of the Michigan Board of Land Surveyors or by a Decree of a Court of Law; established, re-established, monumented, recovered, found as expressed below:

NOTE: Not more than 2 corners, all in the same town and range, may be recorded on this certificate.

A. Description of original monument and accessories and/or subsequent restoration:

- 1826 G.L.O. SYLVESTER SIBLEY, D.S. SET ORIGINAL CORNER.
- 1888 RESURVEY BY SETH PRATT, FOUND OLD STAKE FROM U.S. BEARING TREE MAPLE 5", N21dE, 139 LINKS; W.O. 4", S10-1/4dW, 187 LINKS

	A	B	C	D	E	F	G	H	I	J	K	L	M
1													
2	6		5		4		3		2		1		
3													
4	7		8		9		10		11		12		
5													
6	18		17		16		15		14		13		
7													
8	19		20		21		22		23		24		
9													
10	30		29		28		27		26		25		
11													
12	31		32		33		34		35		36		
13													

SURVEY &
REMONUMENTATION

APR 07 1998


SECTION

B. Description of corner evidence found and/or method applied in restoring or reestablishing corner:

- FOUND RESURVEY TILE WITH 5/8 IRON OVER STUMP FROM 5" MAPLE (PRATT 1888) N21dE, 91.7 FEET 4" W.O. (PRATT 1888) NOW 50" OAK, S14dW 123.5 FEET. ACCEPTED AS TRUE PERPETUATION OF CORNER, SET BERNTSEN MONUMENT IN MONUMENT BOX OVER TILE.

C. Description of monument for corner and accessories established to perpetuate locating the position of the corner:

- BERNTSEN MONUMENT IN MONUMENT BOX
- NAIL AND SPOTTER IN UTILITY POLE, N28dE 56.55 FEET.
- NAIL AND SPOTTER IN 50" OAK, S14dW 123.53 FEET.
- SOUTHWEST CORNER OF HOUSE FOUNDATION, N52dE 102.51 FEET.
- NORTHWEST CORNER OF HOUSE FOUNDATION, S59dE 82.54 FEET.
- NORTHEAST CORNER OF HOUSE FOUNDATION (GARAGE) S66dW 68.64 FEET.

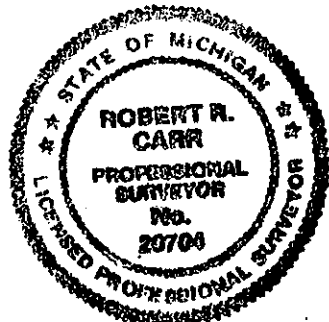

Signed by [Signature]
Surveyor's Michigan License No. 20704

Date OCTOBER 20, 1997