

REMONUMENTATION

FEB 22 1996

COMMISSION

CALHOUN COUNTY REMONUMENTATION

LAND CORNER RECORDATION CERTIFICATE
Filing Requirement of Act 74, Mich. P.A. 1970

APPROVED
Date Oct 18 1995
CALHOUN COUNTY
REMONUMENTATION.

For corners in

Calhoun
(County)

Located In:

Corner Code ##

1. Public Land Survey	T <u>1</u> S R <u>8</u> W	C-12
	T _____ R _____	_____
	T _____ R _____	_____
	T _____ R _____	_____
2. Property Controlling in Section	S _____ T _____ R _____	_____
	S _____ T _____ R _____	_____
3. Miscellaneous Property in Sec.	S _____ T _____ R _____	_____
	S _____ T _____ R _____	_____

STATE OF MICHIGAN
CALHOUN COUNTY
RECORDED

26 OCT 95 10:02 A.M.

ANNE B. HURLINER
Register of Deeds Stamp & File Number

- 1. Lot No. _____, Recorded Plat _____
- 5. Private Claims _____

William K. Crane, in a field survey on October 16, 1995, to hereby certify that under requirements of P.A. 74, Michigan P.A. of 1970, the corner points mentioned in lines 1 and 2 above were in conformance with regulations and rules therefore as required in the current manual of survey instructions of the United States Department of the Interior, Bureau of Land Management or by a decree of a Court of Law and/or that the corner points mentioned in lines 3, 4 and 5 above were in conformance with the rules of the Michigan Board of Land Surveyors or by a Decree of a Court of Law; established, re-established, monumented, re-monumented, recovered, found as expressed below:

NOTE: Not more than 4 corners, all in the same town and range, may be recorded on this certificate.

A	B	C	D	E	F	G	H	I	J	K	L	M
2	6	5	4	3	2	1						
3												
4	7	8	9	10	11	12						
5												
6	18	17	16	15	14	13						
7												
8	19	20	21	22	23	24						
9												
10	30	29	28	27	26	25						
11												
12	31	32	33	34	35	36						
13												

Bedford Township

1. Description of original monument and accessories and/or subsequent restoration:

Original Government Field Notes
S. Sibley 1826):

Resurvey by S. Pratt (1888):

' Burr Oak N16°E 75 links
' Burr Oak N43°W 79 links

U.S. Bearings and post gone. Placed post midway between road fences and in line of board fence on quarter line West. No trees near.

L.C.R.C. recorded in L. 1575, P. 333 for Battle Creek Industrial Park (L. 19, P. 38). Previously recorded in L. 992, P. 31.

3. Description of corner evidence found and/or method applied in restoring or reestablishing corner:

Found capped iron as recorded in L. 1575, P. 333 in butuminous parking lot.


LIBER 1828 PAGE 41

2. Description of monument for corner and accessories established to perpetuate locating the position of the corner:

Replaced capped iron with standard Calhoun County Remonumentation Monument in monument box, 18'± East of centerline of Brydges Drive.

-Utility pole	N20°W	36.51'
-Utility pole	N60°W	72.38'
-21" Boxelder	N80°W	100.51'
-10" Pine	S50°E	135.50'

This is accepted as the best available evidence of the position of the original corner.

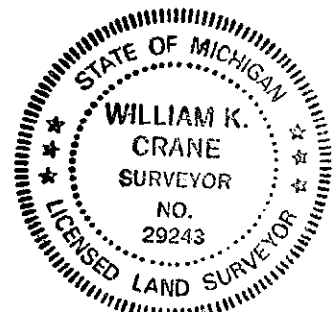

Signed by William K. Crane Date October 18, 1995
Surveyor's Michigan License No. 29243