

REMONUMENTATION

FEB 22 1996

COMMISSION

CALHOUN COUNTY REMONUMENTATION

LAND CORNER RECORDATION CERTIFICATE
Filing Requirement of Act 74, Mich. P.A. 1970

APPROVED
Date May 17, 1995
CALHOUN COUNTY
REMONUMENTATION.

For corners in

<u>CALHOUN</u> (County)	Located In:	Corner Code #
1. Public Land Survey	T <u>1S</u> R <u>8W</u>	<u>C13</u>
	T _____ R _____	_____
	T _____ R _____	_____
	T _____ R _____	_____
2. Property Controlling in Section	S _____ T _____ R _____	_____
	S _____ T _____ R _____	_____
3. Miscellaneous Property in Sec.	S _____ T _____ R _____	_____
	S _____ T _____ R _____	_____
4. Lot No. _____, Recorded Plat _____		
5. Private Claims _____		

STATE OF MICHIGAN
CALHOUN COUNTY
RECORDED

22 MAY 95 10:54 A.M.

ANNE B. NORLANDER
CLERK - REGISTER OF DEEDS

Register of Deeds Stamp & File Number

I, William K. Crane, in a field survey on May 1, 19 95, do hereby certify that under requirements of P.A. 74, Michigan P.A. of 1970, the corner points mentioned in lines 1 and 2 above were in conformance with regulations and rules therefore as required in the current manual of survey instructions of the United States Department of the Interior, Bureau of Land Management or by a decree of a Court of Law and/or that the corner points mentioned in lines 3, 4 and 5 above were in conformance with the rules of the Michigan Board of Land Surveyors or by a Decree of a Court of Law, established, re-established, monumented, re-monumented, recovered, found as expressed below:

NOTE: Not more than 4 corners, all in the same town and range, may be recorded on this certificate.

A	B	C	D	E	F	G	H	I	J	K	L	M
2	6	5	4	3	2	1						
3												
4	7	8	9	10	11	12						
5												
6	18	17	16	15	14	13						
7												
8	19	20	21	22	23	24						
9												
10	30	29	28	27	26	25						
11												
12	31	32	33	34	35	36						
13												

A. Description of original monument and accessories and/or subsequent restoration:

Original Government Field Notes
(S. Sibley 1826)

8" W. Oak N 56 1/2° E 86 links
14" W. Oak N 28° W 81 links

Resurvey by S. Pratt in 1888: (Set post 184 links West of Northeast corner of Section 6 Battle Creek as established by F. Hodgman)

12" B.O. N 77° E 100 links
12" Elm N 72° W 69 links

B. Description of corner evidence found and/or method applied in restoring or reestablishing corner:

Records of DeKeyser & Assoc, (No date)

12" Cedar N 50° E 154.6'
14" Hickory N 7° E 188.0'
20" Elm N 71° W 45.5'
24" Maple N 77° W 66.9'

LCRC recorded by DeKeyser in 1972,
L. 1 P. 22, 1/2 Iron

U. Pole S 19° E 37.18'
U. Pole N 74° E 65.60'
U. Pole S 60° E 73.58'

LCRC by Wetoskey in 1995,
L. 3 P. 808

Found and accepted iron as recorded in L.1 P. 22, placed cap # 19847


NW Cor. Sec. 5 East 121.40'
Conc. L. N 43° E 115.50'
Pole Base
10" Conifer S 50° E 82.63'
NE Cor. S 10° E 73.93'
Bldg.

(This is accepted as the best available evidence of the position of the original corner.)

C. Description of monument for corner and accessories established to perpetuate locating the position of the corner:

Replaced 1/2" rerod with Standard Calhoun County Remonumentation corner (Bersten Monument)

8" Pine South 10.00'
8" Elm N 10° W 45.84'
8" Pine S 45° E 82.80'
8" Pine S 60° E 103.21'
Battle Creek Corner East 121.41'

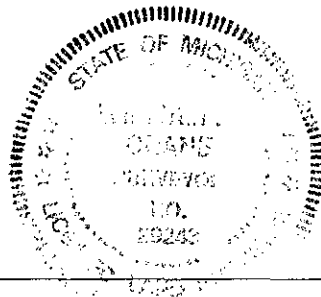

LIBER 1801 PAGE 951

Signed by William K Crane

Date 5/17/95

Surveyor's Michigan License No. 29243