

REMONUMENTATION

FEB 22 1996

CALHOUN COUNTY REMONUMENTATION

COMMISSION

LAND CORNER RECORDATION CERTIFICATE
Filing Requirement of Act 74, Mich. P.A. 1970

APPROVED
Date May 17, 1995
CALHOUN COUNTY
REMONUMENTATION.

For corners in

CALHOUN (County)	Located In:	Corner Code #
1. Public Land Survey	T 1S R 8W	D13
	T ___ R ___	_____
	T ___ R ___	_____
	T ___ R ___	_____
2. Property Controlling in Section	S ___ T ___ R ___	_____
	S ___ T ___ R ___	_____
3. Miscellaneous Property in Sec.	S ___ T ___ R ___	_____
	S ___ T ___ R ___	_____
4. Lot No. _____, Recorded Plat _____		
5. Private Claims _____		

STATE OF MICHIGAN
CALHOUN COUNTY
RECORDED
22 MAY 95 10:54 A.M.
ANNE B. NORLAIDER
CLERK - REGISTER OF DEEDS
Register of Deeds Stamp & File Number

I, William K. Crane, in a field survey on May 1, 19 95, do hereby certify that under requirements of P.A. 74, Michigan P.A. of 1970, the corner points mentioned in lines 1 and 2 above were in conformance with regulations and rules therefore as required in the current manual of survey instructions of the United States Department of the Interior, Bureau of Land Management or by a decree of a Court of Law and/or that the corner points mentioned in lines 3, 4 and 5 above were in conformance with the rules of the Michigan Board of Land Surveyors or by a Decree of a Court of Law; established, re-established, monumented, re-monumented, recovered, found as expressed below:

	A	B	C	D	E	F	G	H	I	J	K	L	M
2	6	5	4	3	2	1							
3													
4	7	8	9	10	11	12							
5													
6	18	17	16	15	14	13							
7													
8	19	20	21	22	23	24							
9													
10	30	29	28	27	26	25							
11													
12	31	32	33	34	35	36							
13													

NOTE: Not more than 4 corners, all in the same town and range, may be recorded on this certificate.

A. Description of original monument and accessories and/or subsequent restoration:

Original Government Field Notes
(S. Sibley 1826)

9" W Oak N 79 E 48 links
14" W Oak N 18 W 56 links

Resurvey by S. Pratt in 1888
Found point by measuring half-way between section corners.
U.S. bearing trees gone.

10" Hickory S82½W 229 links
4 W Oak S74 E 147½ link

B. Description of corner evidence found and/or method applied in restoring or reestablishing corner:

LCRC L.1 P.22 (1972)
DeKeyser & Assoc.

4" Pipe w/o Cap
6" Stump N 80° W 9.22'
9" Spruce S 15° E 37.65'
SE. Cor. N 85° W 64.73'
Conc. Fndn.
N½ Post East 109.13'
Sec. 5

Found pipe as recorded by DeKeyser in 1972. Tile would have been lost due to construction in the area.


(This is accepted as the best available evidence of the position of the original corner.)

C. Description of monument for corner and accessories established to perpetuate locating the position of the corner:

Replaced pipe with standard Calhoun County Remonumentation corner.
(Bersten Monument)

15" Pine S 10° W 38.11'
15" Tree N 80° E 48.75'
8" Tree North 67.20'
Fire S 10° W 118.33'
Hydrant
Battle Creek East 109.13'
Corner

LIBER 1801 PAGE 952

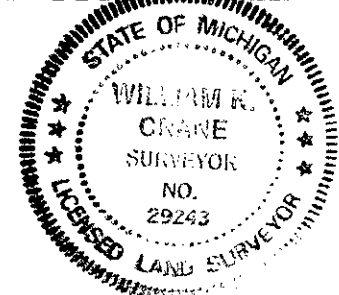

Signed by William K. Crane

Date 5/17/95

Surveyor's Michigan License No. 29243