

REMONUMENTATION

FEB 22 1996

COMMISSION

CALHOUN COUNTY REMONUMENTATION

LAND CORNER RECORDATION CERTIFICATE
Filing Requirement of Act 74, Mich. P.A. 1970

APPROVED
Date May 17, 1995
CALHOUN COUNTY
REMONUMENTATION.

For corners in

Table with columns: CALHOUN (County), Located In:, Corner Code #. Rows include Public Land Survey, Property Controlling in Section, Miscellaneous Property in Sec., Lot No., Private Claims.

STATE OF MICHIGAN
CALHOUN COUNTY
FILED
Recorded
22 MAY 95 10:54 A.M.

Register of Deeds Stamp & File Number
CLERK - REGISTER OF DEEDS

I, William K. Crane, in a field survey on May 8, 1995, do hereby certify that under requirements of P.A. 74, Michigan P.A. of 1970, the corner points mentioned in lines 1 and 2 above were in conformance with regulations and rules therefore as required in the current manual of survey instructions of the United States Department of the Interior, Bureau of Land Management or by a decree of a Court of Law and/or that the corner points mentioned in lines 3, 4 and 5 above were in conformance with the rules of the Michigan Board of Land Surveyors or by a Decree of a Court of Law; established, re-established, monumented, re-monumented, recovered, found as expressed below:

Grid table with columns A-M and rows 2-13. Cell 12,33 contains a black dot.

NOTE: Not more than 4 corners, all in the same town and range, may be recorded on this certificate.

A. Description of original monument and accessories and/or subsequent restoration:

Original Government Field Notes
(S. Sibley 1826)

9" Br. Oak N 85° W 14 links
10" Br. Oak S 86° E 71 links

Resurvey by S. Pratt in 1888:
Found U.S. Bearing tree (alive)

18" Burr Oak N 85° W 13 1/2 link
8" Burr Oak N 1° W 29 1/2 link

B. Description of corner evidence found and/or method applied in restoring or reestablishing corner:

Records of DeKeyser & Assoc. (No date)
Indicate new State Brass Monument

18" Burr Oak N 1° 50' W 19.6'
(NOTE: 29 1/2 links = 19.47" See resurvey above)

Corner recorded in LCRC by
DeKeyser in 1972 L.1 P. 102
Found Brass monument

6" Hickory S 4° 15' W 20.1'
8" Hackberry S 5° 30' W 35.2'
14" W.O. West 365'

U.P. N 15° E 19.40'
14" S 5° W 35.30'
Hackberry
Conc. Mon. North 243.69'

This is accepted as a careful and faithful perpetuation of the position of the original corner.


C. Description of monument for corner and accessories established to perpetuate locating the position of the corner:

Replaced State Brass Monument with Standard Calhoun County Remonumentation corner.
(Bernsten Monument)

Conc. Mon. North 243.69'
U.P. N 15° E 19.30'
10" Elm S 5° W 35.15'
6" Oak S 70° W 20.41'

Corner is approximately 110' South of Railroad Tracks.

LIBER 1801 PAGE 953

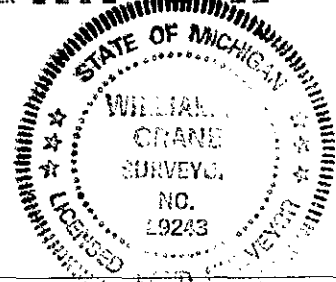

Signed by William K Crane

Date 5/17/95

Surveyor's Michigan License No. 29243