

FEB 22 1996

COMMISSION

CALHOUN COUNTY REMONUMENTATION
LAND CORNER RECORDATION CERTIFICATE
Filing Requirement of Act 74, Mich. P.A. 1970

APPROVED
Date Nov. 22 1995
CALHOUN COUNTY
REMONUMENTATION.

STATE OF MICHIGAN
CALHOUN COUNTY
RECORDED

4 DEC 95 2:27 P.M.

ANNE B. NORLANDER
CLERK - REGISTER OF DEEDS

Register of Deeds Stamp & File Number

For corners in

CALHOUN
(County)

Located In:

Corner Code ##

BEDFORD TOWNSHIP

1. Public Land Survey	T <u>1</u> S R <u>8</u> W	<u>G-9</u>
	T <u> </u> R <u> </u>	<u> </u>
	T <u> </u> R <u> </u>	<u> </u>
	T <u> </u> R <u> </u>	<u> </u>
2. Property Controlling in Section	S <u> </u> T <u> </u> R <u> </u>	<u> </u>
	S <u> </u> T <u> </u> R <u> </u>	<u> </u>
3. Miscellaneous	S <u> </u> T <u> </u> R <u> </u>	<u> </u>
Property in Sec.	S <u> </u> T <u> </u> R <u> </u>	<u> </u>

4. Lot No. _____, Recorded Plat _____
5. Private Claims _____

	A	B	C	D	E	F	G	H	I	J	K	L	M
2	6		5		4		3		2		1		
3													
4	7		8		9		10		11		12		
5													
6	18		17		16		15		14		13		
7													
8	19		20		21		22		23		24		
9													
10	30		29		28		27		26		25		
11													
12	31		32		33		34		35		36		
13													

I, ROBERT R CARR, in a field survey on NOVEMBER 9, 19 95, do hereby certify that under requirements of P.A. 74, Michigan P.A. of 1970, the corner points mentioned in lines 1 and 2 above were in conformance with regulations and rules therefore as required in the current manual of survey instructions of the United States Department of the Interior, Bureau of Land Management or by a decree of a Court of Law and/or that the corner points mentioned in lines 3, 4 and 5 above were in conformance with the rules of the Michigan Board of Land Surveyors or by a Decree of a Court of Law; established, re-established, monumented, re-monumented, recovered, found as expressed below:

NOTE: Not more than 4 corners, all in the same town and range, may be recorded on this certificate.

A. Description of original monument and accessories and/or subsequent restoration:

GLO - SIBLEY, 1826.
RE SURVEY - GIFFORD, 1891, FOUND OLD STAKE FROM BOTH U.S. BEARING TREES


B. Description of corner evidence found and/or method applied in restoring or reestablishing corner:

FOUND RE SURVEY TILE BY GIFFORD, 1891.
NO WITNESSES REMAINING.

LIBER 1834 PAGE 258

C. Description of monument for corner and accessories established to perpetuate locating the position of the corner:

REPLACED TOP TILE WITH BERNTSEN MONUMENT WITH CALHOUN COUNTY REMON
MONUMENT WITH CARSONITE WITNESS POST BESIDE
NAIL & SPOTTER IN 30" OAK, S86°W, 87.83 FEET.
NAIL & SPOTTER IN TWIN 14" OAK, N89°E, 216.14 FEET.
NAIL & SPOTTER IN U-POLE, S24°E, 54.64 FEET.
NAIL & SPOTTER IN RR TIE POST, S60°W, 1.04 FEET.
CENTERLINE OF TOWER LINE, EAST, 100.4 FEET.
FENCES RUNNING SOUTH AND WEST.

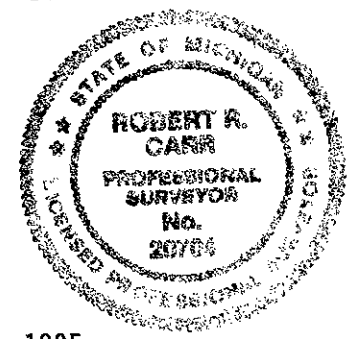

Signed by Robert R. Carr
Surveyor's Michigan License No. 20704

Date NOVEMBER 17, 1995