

REMONUMENTATION

FEB 22 1996

COMMISSION

CALHOUN COUNTY REMONUMENTATION
LAND CORNER RECORDATION CERTIFICATE
Filing Requirement of Act 74, Mich. P.A. 1970

APPROVED
Date Nov. 20, 1995
CALHOUN COUNTY
REMONUMENTATION.

For corners in

<u>CALHOUN</u> (County)	Located In:	Corner Code #/
<u>BEDFORD TOWNSHIP</u>		
1. Public Land Survey	T <u>1</u> S R <u>8</u> W	<u>H-9</u>
	T _____ R _____	_____
	T _____ R _____	_____
	T _____ R _____	_____
2. Property Controlling in Section	S _____ T _____ R _____	_____
	S _____ T _____ R _____	_____
3. Miscellaneous Property in Sec.	S _____ T _____ R _____	_____
	S _____ T _____ R _____	_____
4. Lot No. _____, Recorded Plat _____		
5. Private Claims _____		

STATE OF MICHIGAN
CALHOUN COUNTY
RECORDED

4 DEC 95 2:28 P.M.

ANNE B. NORLANDER
CLERK - REGISTER OF DEEDS

Register of Deeds Stamp & File Number

A	B	C	D	E	F	G	H	I	J	K	L	M
2	6	5	4	3	2	1						
3												
4	7	8	9	10	11	12						
5												
6	18	17	16	15	14	13						
7												
8	19	20	21	22	23	24						
9												
10	30	29	28	27	26	25						
11												
12	31	32	33	34	35	36						
13												

I, ROBERT R. CARR in a field survey on NOVEMBER 9, 19 95, do hereby certify that under requirements of P.A. 74, Michigan P.A. of 1970, the corner points mentioned in lines 1 and 2 above were in conformance with regulations and rules therefore as required in the current manual of survey instructions of the United States Department of the Interior, Bureau of Land Management or by a decree of a Court of Law and/or that the corner points mentioned in lines 3, 4 and 5 above were in conformance with the rules of the Michigan Board of Land Surveyors or by a Decree of a Court of Law; established, re-established, monumented, re-monumented, recovered, found as expressed below:


NOTE: Not more than 4 corners, all in the same town and range, may be recorded on this certificate.

A. Description of original monument and accessories and/or subsequent restoration:

GLO - SIBLEY, 1826
RE SURVEY, GIFFORD, 1891, FOUND POST ESTABLISHED BY PRATT 12 YRS EARLIER
U.S. BEARING TREES GONE.
SET TILE.

B. Description of corner evidence found and/or method applied in restoring or reestablishing corner:

FOUND RE SURVEY TILE BY GIFFORD 1891.
NO WITNESS REMAINING.

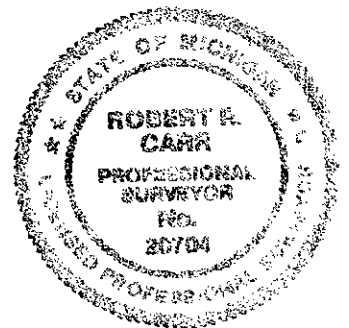

C. Description of monument for corner and accessories established to perpetuate locating the position of the corner:

PLACED BERNTSEN CALHOUN COUNTY REMON MONUMENT OVER BOTTOM TILE
WITH CARSONITE WITNESS POST BESIDE.

LIBER 1834 PAGE 261

NAIL & SPOTTER IN 30" OAK, N59°E, 56.12 FEET
NAIL & SPOTTER IN 36" OAK, N05°E, 51.62 FEET
NAIL & SPOTTER IN U-POLE, S12°E, 23.48 FEET
NAIL & SPOTTER 30" OAK, S38°W, 10.36 FEET
NAIL & SPOTTER IN 30" OAK, N30°W, 57.22 FEET
NAIL & SPOTTER IN TWIN 8" HICKORY, N67°W, 19.00 FEET
CENTERLINE OF GRAVEL ROAD, NORTH, 16± FEET; FENCE RUNNING SOUTH.

Signed by Robert R. Carr Date NOVEMBER 17, 1995
Surveyor's Michigan License No. 20704