

**SURVEY &
REMONUMENTATION**

1993

CALHOUN COUNTY REMONUMENTATION

COMMISSION

**LAND CORNER RECORDATION CERTIFICATE
Filing Requirement of Act 74, Mich. P.A. 1970**

For corners in

CLERK-REGISTER
CALHOUN COUNTY, MICH.
ANNE B. MORLANDER

Oct 26 10 16 AM '93

RECORDED

CALHOUN (County)	Located In:	Corner Code #
1. Public Land Survey	T <u>1S</u> R <u>8W</u>	<u>K-9</u>
	T _____ R _____	_____
	T _____ R _____	_____
BEDFORD TOWNSHIP	T _____ R _____	_____
2. Property Controlling in Section	S _____ T _____ R _____	_____
	S _____ T _____ R _____	_____
3. Miscellaneous Property in Sec.	S _____ T _____ R _____	_____
	S _____ T _____ R _____	_____

Register of Deeds Stamp & File Number

4. Lot No. _____, Recorded Plat _____
5. Private Claims _____

I, ROBERT R. CARR, in a field survey on AUGUST 12, 19 93, do hereby certify that under requirements of P.A. 74, Michigan P.A. of 1970, the corner points mentioned in lines 1 and 2 above were in conformance with regulations and rules therefore as required in the current manual of survey instructions of the United States Department of the Interior, Bureau of Land Management or by a decree of a Court of Law and/or that the corner points mentioned in lines 3, 4 and 5 above were in conformance with the rules of the Michigan Board of Land Surveyors or by a Decree of a Court of Law; established, re-established, monumented, re-monumented, recovered, found as expressed below:

A	B	C	D	E	F	G	H	I	J	K	L	M
2	6	5	4	3	2	1						
3												
4	7	8	9	10	11	12						
5												
6	18	17	16	15	14	13						
7												
8	19	20	21	22	23	24						
9												
10	30	29	28	27	26	25						
11												
12	31	32	33	34	35	36						
13												

NOTE: Not more than 4 corners, all in the same town and range, may be recorded on this certificate.

A. Description of original monument and accessories and/or subsequent restoration:

RESURVEY	C.F. CHAMBERS 1945	DAVIS 1962
FOUND REMAINS OF STAKE AND ONE BRICK	2" I.S.	IRON STAKE
TILE WHITE OAK 12" N25°E 75 LKS	12" HICKORY S30°W 95 FT	U-POLE WNW 55.51 FT
HICKORY 6" S56°W 80 LKS	12" OAK N35°E 36.7 FT	U-POLE ENE 68.51 FT
	4" OAK N60°E 47.5 FT	GUY POLE WSW 64.80 FT
	24" ASH N45°W 39.7 FT	14" OAK SSE 78.28 FT
	12" HICKORY N65°2 58 FT	2 FT EAST OF CENTERLINE ROAD SOUTH
	10" OAK S30°E 78 FT	3 FT SOUTH OF CENTERLINE E/W ROAD


B. Description of corner evidence found and/or method applied in restoring or reestablishing corner:

FOUND 3/4 " IRON PIPE OVER 2" IRON PIPE IN CONCRETE OVER TILE
SEVERAL WITNESSES REMAINING
REMOVED 3/4" IRON PIPE & 2" IRON PIPE IN CONCRETE AND PLACED
STANDARD CAL CO REMON MONUMENT WITH BRASS CAP AND MONUMENT BOX OVER TILE

C. Description of monument for corner and accessories established to perpetuate locating the position of the corner:

STANDARD CAL CO REMON MONUMENT WITH BRASS CAP AND MONUMENT BOX OVER TILE
NAIL & SPOTTER IN ROOT ON S.E. SIDE OF 30" OAK N51°E 37.30 FT
NAIL & SPOTTER IN N.E. SIDE OF U-POLE 1.0 FT ABOVE GROUND N60°W 55.41 FT
FACE OF 4" DIA STEEL BATTLE CREEK GAS CO PIPE LINE MARKER S78°W 83.16 FT
FACE OF VENT PIPE TO BATTLE CREEK GAS CO MANHOLE S42°E 67.80 FT
4'± SOUTH OF CENTERLINE E/W ROAD, 3'± EAST OF CENTERLINE ROAD TO SOUTH,
18.5' EAST OF CENTELRINE OF ROAD TO NORTH

LIBER 1711 PAGE 100

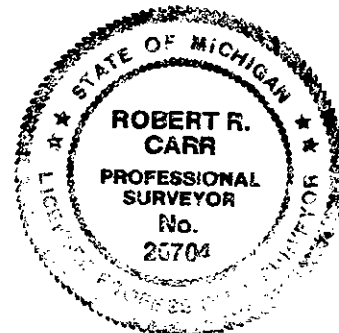

Signed by [Signature]

Date OCT 20, 1993

Surveyor's Michigan License No. 20704