

SURVEY &  
REMONUMENTATION

1993

COMMISSION

CALHOUN COUNTY REMONUMENTATION  
LAND CORNER RECORDATION CERTIFICATE  
Filing Requirement of Act 74, Mich. P.A. 1970

RECORDED

Nov 18 2 21 PM '93

CLERK-REGISTER  
CALHOUN COUNTY, MICH.  
ANNE B. NORLANDER

For corners in

CALHOUN (County) BEDFORD TOWNSHIP	Located In:	Corner Code #
1. Public Land Survey	T 1S R 8W	L-13
	T R	
	T R	
	T R	
2. Property Controlling in Section	S T R	
	S T R	
3. Miscellaneous Property in Sec.	S T R	
	S T R	

Register of Deeds Stamp & File Number

4. Lot No. \_\_\_\_\_, Recorded Plat \_\_\_\_\_  
5. Private Claims \_\_\_\_\_

I, ROBERT R. CARR, in a field survey on OCTOBER 15, 19 93, do hereby certify that under requirements of P.A. 74, Michigan P.A. of 1970, the corner points mentioned in lines 1 and 2 above were in conformance with regulations and rules therefore as required in the current manual of survey instructions of the United States Department of the Interior, Bureau of Land Management or by a decree of a Court of Law and/or that the corner points mentioned in lines 3, 4 and 5 above were in conformance with the rules of the Michigan Board of Land Surveyors or by a Decree of a Court of Law; established, re-established, monumented, re-monumented, recovered, found as expressed below:

	A	B	C	D	E	F	G	H	I	J	K	L	M
2	6		5		4		3		2		1		
3													
4	7		8		9		10		11		12		
5													
6	18		17		16		15		14		13		
7													
8	19		20		21		22		23		24		
9													
10	30		29		28		27		26		25		
11													
12	31		32		33		34		35		36		
13													

**NOTE: Not more than 4 corners, all in the same town and range, may be recorded on this certificate.**

A. Description of original monument and accessories and/or subsequent restoration:

L-13 DUG AND FOUND STAKE. (RE-SURVEY)  
WHITE OAK 12" S30°W, 61-1/2 LINKS.  
WHITE OAK 8" S34-1/2°E, 102 LINKS.

ADDITIONAL WITNESSES  
SOURCE UNKNOWN  
TILE.  
WHITE OAK 14" S22-1/2°W, 41.58 FT.  
WHITE OAK 10" N46°W, 41.58 FT.  
HICKORY 12" N8-1/2°W, 76.89 FT.  
BLACK OAK 12" N80°W, 204.6 FT.  
BLACK OAK 6" WEST, 18 FT.  
NW CORNER TOWER SE, 53.2 FT.  
12" WHITE OAK SE, 59.5 FT.

C.P. CO. PROPERTY STAKE  
NW, 46.5 FT.  
PLAT OF "SUBDIVISION OF  
LOT B OF WASHINGTON  
HEIGHTS".  
PLAT OF "WILLIAMS  
SUBDIVISION".


B. Description of corner evidence found and/or method applied in restoring or reestablishing corner:

L-13 ALL ABOVE WITNESSES GONE.  
ESTABLISHED CORNER LOCATION FROM PLATTED STREET LINES, DUG AND FOUND RE-SURVEY TILE.

LIBER 1716 PAGE 443

C. Description of monument for corner and accessories established to perpetuate locating the position of the corner:

L-13 REPLACED CLAY TILE WITH STANDARD CALHOUN COUNTY REMON MONUMENT WITH BRONZE CAP IN MONUMENT BOX.  
1.8 FT. WEST OF PAINTED CENTERLINE OF WASHINGTON AVENUE ON SOUTH RIGHT-OF-WAY LINE OF PARKWAY DRIVE.  
NAIL AND SPOTTER IN NORTH SIDE OF U-POLE N65°W, 27.36 FT.  
NAIL AND SPOTTER IN WEST SIDE OF 36" OAK S27°E, 67.56 FT.  
NW CORNER OF HOUSE FOUNDATION S63°E, 59.18 FT.  
SOUTH RIM OF SANITARY MANHOLE N07°E, 32.33 FT.

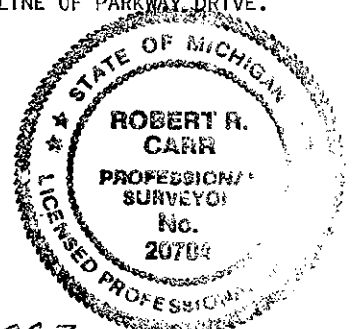

Signed by Robert R. Carr  
ROBERT R. CARR  
Surveyor's Michigan License No. 20704

Date NOV 15, 1993