

**SURVEY &  
REMONUMENTATION**

APR 26 1995

**APPROVED**

ate 11-28-94  
**CALHOUN COUNTY  
REMONUMENTATION.**

**COMMISSION  
CALHOUN COUNTY REMONUMENTATION  
LAND CORNER RECORDATION CERTIFICATE  
Filing Requirement of Act 74, Mich. P.A. 1970**

STATE OF MICHIGAN  
CALHOUN COUNTY  
RECORDED

29 NOV 94 10:23 A.M.

ANNE B. NORLANDER  
CLERK - REGISTER OF DEEDS

**Register of Deeds Stamp & File Number**

For corners in

<u>CALHOUN</u> (County)	Located In:	Corner Code #
BEDFORD TWP.		
1. Public Land Survey	T <u>1</u> S <u>8</u> W	<u>M-10</u>
	T _____ R _____	_____
	T _____ R _____	_____
	T _____ R _____	_____
2. Property Controlling in Section	S _____ T _____ R _____	_____
	S _____ T _____ R _____	_____
3. Miscellaneous Property in Sec.	S _____ T _____ R _____	_____
	S _____ T _____ R _____	_____
4. Lot No. _____, Recorded Plat _____		
5. Private Claims _____		

	A	B	C	D	E	F	G	H	I	J	K	L	M
2	6		5		4		3		2				
3													
4	7		8		9		10		11		12		
5													
6	18		17		16		15		14		13		
7													
8	19		20		21		22		23		24		
9													
10	30		29		28		27		26		25		
11													
12	31		32		33		34		35		36		
13													

I, ROBERT R. CARR, in a field survey on NOVEMBER 22, 19 94, do hereby certify that under requirements of P.A. 74, Michigan P.A. of 1970, the corner points mentioned in lines 1 and 2 above were in conformance with regulations and rules therefore as required in the current manual of survey instructions of the United States Department of the Interior, Bureau of Land Management or by a decree of a Court of Law and/or that the corner points mentioned in lines 3, 4 and 5 above were in conformance with the rules of the Michigan Board of Land Surveyors or by a Decree of a Court of Law; established, re-established, monumented, re-monumented, recovered, found as expressed below:

**NOTE: Not more than 4 corners, all in the same town and range, may be recorded on this certificate.**

**A. Description of original monument and accessories and/or subsequent restoration:**

ORIGINAL CORNER SET BY SIBLEY 1826  
RE-SURVEY CORNER SET BY GIFFORD 1891.  
ESTABLISHED HALF-WAY BETWEEN SECTION CORNERS ON LINE

DEKEYSER 1976 MONUMENT BOX AND 4 WITNESSES  
L.C.R.C. BOOK 2 PAGE 35 LIBER 1106 PAGE 910  
IRON STAKE IN CASTING SAME WITNESSES AS DEKEYSER 1976.


**B. Description of corner evidence found and/or method applied in restoring or reestablishing corner:**

STAKE AND CASTING REMOVED IN ROAD CONSTRUCTION.  
ESTABLISHED CORNER LOCATION FROM 3 REMAINING WITNESSES  
FROM L.C.R.C. LIBER 1106 PAGE 910 DUG 3 FEET DEEP AND FOUND PIECES OF  
HOLLOW TIEE AND BITS OF BRICK AT BOTTOM OF HOLE.  
PLACED BRENTSEN MONUMENT IN MONUMENT BOX.

LIBER 1778 PAGE 569

**C. Description of monument for corner and accessories established to perpetuate locating the position of the corner:**

BRENTSEN MONUMENT IN MONUMENT BOX.  
NAIL & SPOTTER IN SOUTHWEST SIDE OF U-POLE S49°E 59.33 FEET.  
NAIL & SPOTTER IN SOUTHEAST SIDE OF U-POLE N63°E 58.39 FEET.  
NAIL & SPOTTER IN NORTHEAST SIDE OF U-POLE N40°W 49.34 FEET  
CENTER TOP NUT OF FIRE HYDRANT S38°W 50.61 FEET.

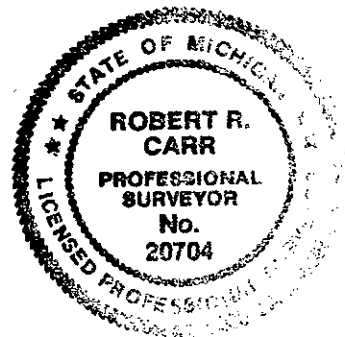

Signed by [Signature] Date NOVEMBER 28, 1994  
Surveyor's Michigan License No. 20704