

CALHOUN COUNTY REMONUMENTATION  
**LAND CORNER RECORDATION CERTIFICATE**  
 Filing Requirement of Act 74, Mich. P.A. 1970

**APPROVED**  
 Date 8/16/95 *ADJ.*  
**CALHOUN COUNTY**  
**REMONUMENTATION.**

For corners in <u>Calhoun</u> (County)	Located In:	Corner Code #
1. Public Land Survey	T <u>2</u> S R <u>4</u> W	<u>G-13</u>
	T _____ R _____	_____
	T _____ R _____	_____
	T _____ R _____	_____
2. Property Controlling in Section	S _____ T _____ R _____	_____
	S _____ T _____ R _____	_____
3. Miscellaneous Property in Sec.	S _____ T _____ R _____	_____
	S _____ T _____ R _____	_____

STATE OF MICHIGAN  
 CALHOUN COUNTY  
 RECORDED  
 30 AUG 95 11:28 A.M.  
 ANNE B. NORLANDER  
 Register of Deeds Stamp & File Number

1. Lot No. \_\_\_\_\_, Recorded Plat \_\_\_\_\_  
 5. Private Claims \_\_\_\_\_

	A	B	C	D	E	F	G	H	I	J	K	L	M
2	6	5	4	3	2	1							
3													
4	7	8	9	10	11	12							
5													
6	18	17	16	15	14	13							
7													
8	19	20	21	22	23	24							
9													
10	30	29	28	27	26	25							
11													
12	31	32	33	34	35	36							
13													

Donald J. Davis, in a field survey on July 19, 19 95,  
 to hereby certify that under requirements of P.A. 74, Michigan P.A. of 1970, the corner points mentioned  
 in lines 1 and 2 above were in conformance with regulations and rules therefore as required in the  
 current manual of survey instructions of the United States Department of the Interior, Bureau of Land  
 Management or by a decree of a Court of Law and/or that the corner points mentioned in lines 3, 4 and 5  
 above were in conformance with the rules of the Michigan Board of Land Surveyors or by a Decree of a  
 Court of Law; established, re-established, monumented, re-monumented, recovered, found as  
 expressed below:

**NOTE: Not more than 4 corners, all in the same town and range, may be recorded  
 on this certificate.**

1. Description of original monument and accessories and/or subsequent restoration:

Original survey in 1825 by Lyon.  
 16" Yellow Oak N 44° E 38 links, 12" White Oak N 41° W 63 links.  
 Iron set by R.L. Barry in 1938, RLS #2258.  
 Iron found by Alden in 1962.  
 Face concrete fence corner S 80° W 28.8'  
 Iron used in various surveys in area.

2. Description of corner evidence found and/or method applied in restoring or reestablishing corner:

Iron removed by City of Albion in construction of water main.  
 Reset point from adjacent surveys.  
 Accepted as good location of corner.

**REMONUMENTATION**


**LIBER 1818 PAGE 322**

**FEB 22 1996**

**COMMISSION**

3. Description of monument for corner and accessories established to perpetuate locating the position of the corner:

Set Harrison monument at point.  
 Nail & Tag 36" Cherry S 30° W 53.92'  
 Nail & Tag 28" Oak S 45° W, 40.56'  
 Face concrete fence post S 80° W, 28.71'  
 Nail & Tag 14" Ash N 45° W, 67.43'  
 NE corner Section 4, T3S, R4W, West 29.8'.

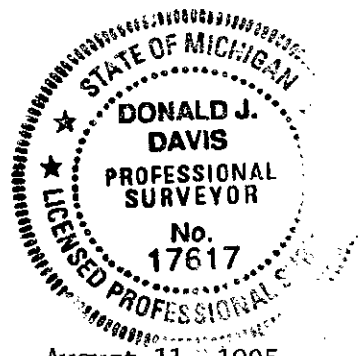

Signed by Donald J. Davis

Date August 11, 1995

Surveyor's Michigan License No. 17617