

**CALHOUN COUNTY REMONUMENTATION  
LAND CORNER RECORDATION CERTIFICATE  
Filing Requirement of Act 74, Mich. P.A. 1970**

**APPROVED**  
Date 8/11/95 LDJ  
**CALHOUN COUNTY  
REMONUMENTATION.**

For corners in  
Calhoun

(County)

Located In:

Corner Code #

- |                                       |                           |       |
|---------------------------------------|---------------------------|-------|
| 1. Public Land Survey                 | T <u>2</u> S R <u>4</u> W | I-11  |
|                                       | T ___ R ___               | _____ |
|                                       | T ___ R ___               | _____ |
|                                       | T ___ R ___               | _____ |
| 2. Property Controlling<br>in Section | S ___ T ___ R ___         | _____ |
|                                       | S ___ T ___ R ___         | _____ |
| 3. Miscellaneous<br>Property in Sec.  | S ___ T ___ R ___         | _____ |
|                                       | S ___ T ___ R ___         | _____ |

STATE OF MICHIGAN  
CALHOUN COUNTY  
RECORDED

30 AUG 95 11:28 A.M.

ANNE B. NORLANDER  
CLERK - REGISTER OF DEEDS  
Register of Deeds Stamp & File Number

4. Lot No. \_\_\_\_\_, Recorded Plat \_\_\_\_\_
5. Private Claims \_\_\_\_\_

	A	B	C	D	E	F	G	H	I	J	K	L	M
2	6	5	4	3	2	1							
3													
4	7	8	9	10	11	12							
5													
6	18	17	16	15	14	13							
7													
8	19	20	21	22	23	24							
9													
10	30	29	28	27	26	25							
11													
12	31	32	33	34	35	36							
13													

I, Donald J. Davis, in a field survey on August 10, 1995, do hereby certify that under requirements of P.A. 74, Michigan P.A. of 1970, the corner points mentioned in lines 1 and 2 above were in conformance with regulations and rules therefore as required in the current manual of survey instructions of the United States Department of the Interior, Bureau of Land Management or by a decree of a Court of Law and/or that the corner points mentioned in lines 3, 4 and 5 above were in conformance with the rules of the Michigan Board of Land Surveyors or by a Decree of a Court of Law; established, re-established, monumented, re-monumented, recovered, found as expressed below:

**NOTE: Not more than 4 corners, all in the same town and range, may be recorded on this certificate.**

**A. Description of original monument and accessories and/or subsequent restoration:**

Original survey in 1825 by Lyon.  
8" Burr Oak S 26° W, 74 links.  
22" White Oak N 74° E, 63 links.

RR spike in road, M.D.S.H., 1959.  
22" Elm S 46° W, 38.0'; 30" Elm N 41° W, 39.16',  
26" Walnut N 22° E, 65.93'.

1/2" rod in monument box, M.D.S.H., Liber 1050, page 840.

**B. Description of corner evidence found and/or method applied in restoring or reestablishing corner:**

Found 1/2" iron in broken monument box on centerline of 28 Mile Road (Eaton St) and checked to witnesses. Monument box broken by shifting of concrete road.

Accepted as good location of corner perpetuation.

COMMISSION  
REMONUMENTATION

FEB 22 1996


COMMISSION

LIBER 1818 PAGE 323

**C. Description of monument for corner and accessories established to perpetuate locating the position of the corner:**

Set Harrison monument in concrete in centerline of Eaton Street.

Nail & tag Utility pole S 40° W, 40.65'.  
Nail & Tag Utility pole N 80° W, 76.90'.  
NW corner concrete base Plaza sign, S 80° E, 62.50'.  
Centerline top nut hydrant S 40° E, 75.38'.

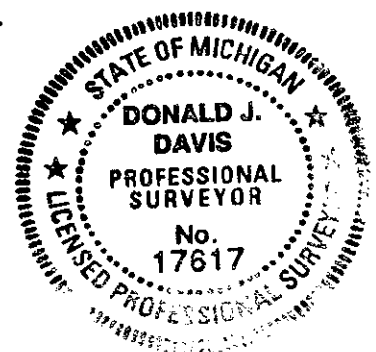

Signed by Donald J. Davis

Date August 11, 1995

Surveyor's Michigan License No. 17617