

MAR 30 1999

APPROVED

Date 11-18-98 RRL
CALHOUN COUNTY
REMONUMENTATION.

CALHOUN COUNTY REMONUMENTATION
LAND CORNER RECORDATION CERTIFICATE
Filing Requirement of Act 74, Mich. P.A. 1970

STATE OF MICHIGAN
CALHOUN COUNTY
RECORDED

For corners in

CALHOUN

Located In:

Corner Code #

(County)

SHERIDAN TOWNSHIP

1. Public Land Survey

T 2S R 4W

K-3

T R

T R

T R

T R

2. Property Controlling
in Section

S

T R

S

T R

3. Miscellaneous
Property in Sec.

S

T R

S

T R

4. Lot No. _____, Recorded Plat _____

5. Private Claims _____

19 NOV 1998 3:32:48 PM

ANNE B. NORLANDER
CLERK - REGISTER OF DEEDS

LIBER **2079** PAGE **919**

Register of Deeds Stamp & File Number

I, Michael A. Groat, in a field survey on October 29, 19 98, do hereby state that under requirements of P.A. 74, Michigan P.A. of 1970, the corner points mentioned in lines 1 and 2 above were in conformance with regulations and rules therefore as required in the current manual of survey instructions of the United States Department of the Interior, Bureau of Land Management or by a decree of a Court of Law and/or that the corner points mentioned in lines 3, 4 and 5 above were in conformance with the rules of the Michigan Board of Land Surveyors or by a Decree of a Court of Law; established, re-established, monumented, recovered, found as expressed below:

NOTE: Not more than 2 corners, all in the same town and range, may be recorded on this certificate.

	A	B	C	D	E	F	G	H	I	J	K	L	M
1													
2	6		5		4		3		2		1		
3													
4	7		8		9		10		11		12		
5													
6	18		17		16		15		14		13		
7													
8	19		20		21		22		23		24		
9													
10	30		29		28		27		26		25		
11													
12	31		32		33		34		35		36		
13													

A. Description of original monument and accessories and/or subsequent restoration:


ORIGINAL SURVEY BY LUCIUS LYON, DEPUTY SURVEYOR, 1825, SET POST, W. OAK, 9", NORTH 89° EAST, 23 LINKS, W. OAK, 10" SOUTH 61° WEST, 14 LINKS.
R.R. CARR, OCT. 1971, FOUND 5/8" IRON STAKE, NOTED A ERRONEOUS CORNER 3' SOUTH & 7' EAST.
U.P. NORTH 70° EAST, 56.54', 3" STEEL FENCE POST, SOUTH 20° WEST, 52.77', 15" HICKORY, SOUTH 15° EAST, 102.40'.
WITNESSES ON BOUNDARY SURVEY BY CARR & ASSOC., JOB NO. 91-3284-A, HICKORY AS ABOVE, 30" OAK, NORTH 60° EAST, 71.61'; TELE. RISER GUARD, NORTH 55° EAST, 56.45'; 4± WEST OF CENTERLINE OF NORTH & SOUTH ROAD; IN CENTERLINE OF EAST & WEST ROAD.

B. Description of corner evidence found and/or method applied in restoring or reestablishing corner:

WE FOUND BOTH CORNERS AS NOTED BY R.R. CARR. EXCAVATED AT BOTH POSITIONS. FOUND NOTHING BENEATH THE R.R. SPIKE. 2' BELOW THE 5/8" IRON, FOUND A LARGE SANDSTONE. ACCEPTED THE 5/8" IRON AS THE BEST LOCATION FOR THE CORNER.

C. Description of monument for corner and accessories established to perpetuate locating the position of the corner:

SET BERNTSEN MONUMENT IN MONUMENT BOX.
NAIL & TAG IN 30" OAK, NORTH 69° EAST, 72.25'
NAIL & TAG IN 18" HICKORY, SOUTH 15° EAST, 102.72'
NAIL & TAG IN 18" OAK, SOUTH 17° WEST, 130.25'
NAIL & TAG IN UTILITY POLE, SOUTH 70° WEST, 158.75'

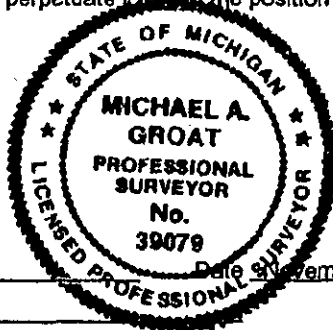

Signed by

[Signature]

Date November 3, 1998

Surveyor's Michigan License No. 39079