

RECORDED

Researched  
8-16-93

FEB 22 1996

APPROVED

COMMISSIONER Calhoun County Remonumentation  
LAND CORNER RECORDATION CERTIFICATE  
Filing Requirement of Act 74, Mich. P.A. 1970

Date SEPT 15 1993  
CALHOUN COUNTY  
REMONUMENTATION.

LDYH

For corners in

Calhoun

Located In:

Corner Code #

(County)  
Marengo Twp.

- |                                       |   |     |   |     |     |
|---------------------------------------|---|-----|---|-----|-----|
| 1. Public Land Survey                 | T | 2 S | R | 5 W | A-1 |
|                                       | T |     | R |     |     |
|                                       | T |     | R |     |     |
|                                       | T |     | R |     |     |
| 2. Property Controlling in Section    | S |     | T | R   |     |
|                                       | S |     | T | R   |     |
| 3. Miscellaneous Property in Sec.     | S |     | T | R   |     |
|                                       | S |     | T | R   |     |
| 4. Lot No. _____, Recorded Plat _____ |   |     |   |     |     |
| 5. Private Claims _____               |   |     |   |     |     |

STATE OF MICHIGAN  
CALHOUN COUNTY  
RECORDED

9 NOV 95 9:59 A.M.

Register of Deeds Stamp & File Number  
CLERK - REGISTER OF DEEDS

I, Donald J. Davis, in a field survey on September 8, 1993, do hereby certify that under requirements of P.A. 74, Michigan P.A. of 1970, the corner points mentioned in lines 1 and 2 above were in conformance with regulations and rules therefore as required in the current manual of survey instructions of the United States Department of the Interior, Bureau of Land Management or by a decree of a Court of Law and/or that the corner points mentioned in lines 3, 4 and 5 above were in conformance with the rules of the Michigan Board of Land Surveyors or by a Decree of a Court of Law; established, re-established, monumented, re-monumented, recovered, found as expressed below:

A	B	C	D	E	F	G	H	I	J	K	L	M
2	6	5	4	3	2	1						
3												
4	7	8	9	10	11	12						
5												
6	18	17	16	15	14	13						
7												
8	19	20	21	22	23	24						
9												
10	30	29	28	27	26	25						
11												
12	31	32	33	34	35	36						
13												

NOTE: Not more than 4 corners, all in the same town and range, may be recorded on this certificate.

A. Description of original monument and accessories and/or subsequent restoration:

Tile set in resurvey of Marengo Township in 1825. Relocated in survey by Gifford in 1891.  
10" Maple N 72° E 120 links.  
12" Hickory N 74-3/4° W 190 links.

B. Description of corner evidence found and/or method applied in restoring or reestablishing corner:


Found 1 1/2" iron pipe in tile as set in resurvey. Recorded in 1974 in Liber 1039, page 442.  
26" Maple N 55° E 61.59'  
14" Hickory N 35° W 44.70'  
Utility Pole S 60° W 49.97'

Corner accepted as true corner as preserved by local surveyors.

LIBER 1830 PAGE 891

C. Description of monument for corner and accessories established to perpetuate locating the position of the corner:

Set Harrison monument in monument box in gravel road.  
PK Nail 26" Maple N 55° E 61.35'  
Nail & Tag 14" Hickory N 35° W 44.53'  
PK Nail 28" Oak N 50° W 65.42'  
West corner of house foundation S 40° E 106.50'

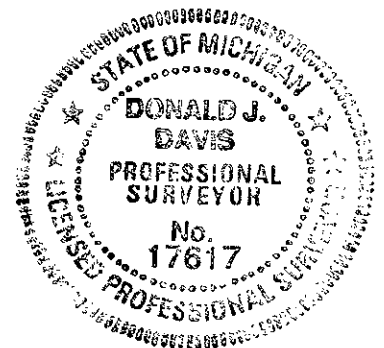

Signed by Donald J. Davis  
Donald J. Davis  
Surveyor's Michigan License No. 17617

Date November 7, 1995