

APPROVED

Date 11/25/97 RRC
**CALHOUN COUNTY
REMONUMENTATION.**

**CALHOUN COUNTY REMONUMENTATION
LAND CORNER RECORDATION CERTIFICATE**
Filing Requirement of Act 74, Mich. P.A. 1970

STATE OF MICHIGAN
CALHOUN COUNTY
RECORDED

1 DEC 97 4:51 P.M.

ANNE B. NORLANDER
CLERK - REGISTER OF DEEDS

For corners in
CALHOUN

Located In: Corner Code #

(County)
MARENGO TOWNSHIP
1. Public Land Survey

T 2S R 5W 1-7

2. Property Controlling
in Section

S T R

3. Miscellaneous
Property in Sec.

S T R

LIBER **1980** PAGE **508**

Register of Deeds Stamp & File Number

4. Lot No. _____, Recorded Plat _____
5. Private Claims _____

I, MICHAEL A. GROAT, in a field survey on NOVEMBER 11, 1997 do hereby state that under requirements of P.A. 74, Michigan P.A. of 1970, the corner points mentioned in lines 1 and 2 above were in conformance with regulations and rules therefore as required in the current manual of survey instructions of the United States Department of the Interior, Bureau of Land Management or by a decree of a Court of Law and for that the corner points mentioned in lines 3, 4 and 5 above were in conformance with the rules of the Michigan Board of Land Surveyors or by a Decree of a Court of Law; established, re-established, monumented, recovered, found as expressed below:

	A	B	C	D	E	F	G	H	I	J	K	L	M
1													
2	6	5	4	3	2	1							
3													
4	7	8	9	10	11	12							
5													
6	10	17	16	15	14	13							
7													
8	19	20	21	22	23	24							
9													
10	30	29	28	27	26	25							
11													
12	31	32	33	34	35	36							
13													

NOTE: Not more than 2 corners, all in the same town and range, may be recorded on this certificate.

A. Description of original monument and accessories and/or subsequent restoration:

ORIGINAL SURVEY BY LUCIUS LYON, DEPUTY SURVEYOR, SET POST, B. OAK, 9", S31°W, 30LKS; B. OAK, 11", N8-1/2°W, 108 LKS.

J.M. GIFFORD, 1889, FOUND BOTTOM OF OLD STAKE IN LINE WITH FENCE RUNNING NORTH. SET TILE, B. OAK, 4", N75°W, 164LKS; 48 LKS SOUTH OF STONE WALL

M.S.H.D., 1959, TILE WITH IRON OVER IT. 2' CONCRETE FENCE POST, S2°W, 31.15'; 30" W. OAK, S89°E, 66.20'; 6" CHERRY, S57°W, 48.58'; 10" CHERRY, N61°W, 63.85'.

R.R. CARR, P.S. #20704 IN SURVEY JOB NO. 94-7390, NOTES A 1/2" IRON STAKE, 30" OAK, S88°E, 6.47'; R.R. TIE FENCE POST, N3°E, 31.95'; 14" CHERRY, S48°W, 49.01', 16" CHERRY, S58°E, 72.66'


B. Description of corner evidence found and/or method applied in restoring or reestablishing corner:

FOUND 1/2" IRON WITH LARGE ROCK BENEATH. EXCAVATED BUT FOUND NO REMAINS OF TILE. CHECKED INTO REMAINING WITNESSES FROM ABOVE. ACCEPTED THIS LOCATION AS A FAITHFUL AND CAREFUL PERPETUATION OF THE ORIGINAL CORNER.

C. Description of monument for corner and accessories established to perpetuate locating the position of the corner:

THE CORNER IS A BERNTSEN MONUMENT IN A MONUMENT BOX.

HOLE IN CONCRETE FENCE POST, SOUTH, 32.30 FEET
NAIL AND TAG IN A 30" B. OAK, S30°W, 31.34 FEET
NAIL AND TAG IN A 30" W. OAK, N30°E, 70.68 FEET
NAIL AND TAG IN A 15" W. OAK, N70°E, 70.68 FEET
3.5 FEET SOUTH OF CENTERLINE.

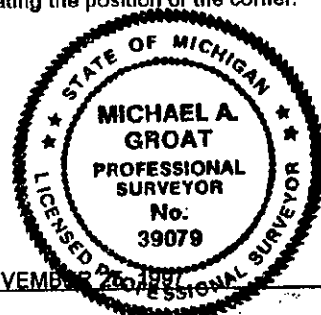

Signed by [Signature] Date NOVEMBER 20, 1997

Surveyor's Michigan License No. 39079

**SURVEY &
REMONUMENTATION**

FORM APPROVED BY MICHIGAN STATE BOARD OF PROFESSIONAL SURVEYORS, JAN. 28, 1974
REVISED MAY 14, 1978
REVISED JAN., 1983
REVISED OCT., 1986

APR 07 1998

SECTION