

SURVEY & REMONUMENTATION

APPROVED
 Date SEPT 18, 1996
CALHOUN COUNTY REMONUMENTATION.

CALHOUN COUNTY REMONUMENTATION
LAND CORNER RECORDATION CERTIFICATE
 Filing Requirement of Act 74, Mich. P.A. 1970

MAR 21 1997
COMMISSION

For corners in
Calhoun
 (County)

Located In:	Corner Code #
T <u>2S</u> R <u>6W</u>	<u>A-7</u>
T _____ R _____	_____
T _____ R _____	_____
T _____ R _____	_____
T _____ R _____	_____
S _____ T _____ R _____	_____
S _____ T _____ R _____	_____
S _____ T _____ R _____	_____
S _____ T _____ R _____	_____

STATE OF MICHIGAN
 CALHOUN COUNTY
 RECORDED
 24 SEP 96 10:56 A.M.
 ANNE B. NORLANDER
 CLERK - REGISTER OF DEEDS
Register of Deeds Stamp & File Number

4. Lot No. _____, Recorded Plat _____
 5. Private Claims _____

I, Donald J. Davis, in a field survey on August 10, 1996, do hereby certify that under requirements of P.A. 74, Michigan P.A. of 1970, the corner points mentioned in lines 1 and 2 above were in conformance with regulations and rules therefore as required in the current manual of survey instructions of the United States Department of the Interior, Bureau of Land Management or by a decree of a Court of Law and/or that the corner points mentioned in lines 3, 4 and 5 above were in conformance with the rules of the Michigan Board of Land Surveyors or by a Decree of a Court of Law; established, re-established, monumented, re-monumented, recovered, found as expressed below:

	A	B	C	D	E	F	G	H	I	J	K	L	M
2	6	5	4	3	2	1							
3													
4	7	8	9	10	11	12							
5													
6	13	17	16	15	14	13							
7													
8	19	20	21	22	23	24							
9													
10	30	29	28	27	26	25							
11													
12	31	32	33	34	35	36							
13													

NOTE: Not more than 4 corners, all in the same town and range, may be recorded on this certificate.

A. Description of original monument and accessories and/or subsequent restoration:

Original Survey in 1825 by Lyon.
 30" Burr Oak S 15° E 1.36 links
 16" White Oak N 58° E 1.46 links

Resurvey in 1890 by Gifford.
 Set stone 30 links South of Emmett corner (M-7) 7 links north of fence line.

Marshall Twp.


B. Description of corner evidence found and/or method applied in restoring or reestablishing corner:

Found no evidence of corner or witnesses.
 Reset corner 30 links (19.8') south of Emmett corner (M-7) on Town line as established from northwest corner Section 18, T2S, R6W, to East 1/4 corner of Section 24, T2S, R7W, (A-8, found tile) location is in open field.

LIBER 1887 PAGE 971

C. Description of monument for corner and accessories established to perpetuate locating the position of the corner:

Set Berntsen monument.
 Falls in lane between cultivated fields.
 2611.77' north of East 1/4 Post Sec.24, T2S, R7W, which is monument in swamp.
 478' East of fence row to south.
 285.45' West of GPS station of Wolford's survey of Calhoun County.

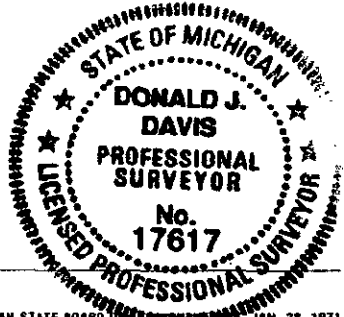

Signed by Donald J. Davis
 Surveyor's Michigan License No. 17617

Date August 15, 1996