

**SURVEY &  
REMONUMENTATION**

MAR 21 1997

COMMISSION

**APPROVED**  
Date Oct 15, 1996  
**CALHOUN COUNTY  
REMONUMENTATION.**

CALHOUN COUNTY REMONUMENTATION  
**LAND CORNER RECORDATION CERTIFICATE**  
Filing Requirement of Act 74, Mich. P.A. 1970

STATE OF MICHIGAN  
CALHOUN COUNTY  
RECORDED

18 OCT 96 2:29 P.M.

ANNE B. NORLANDER  
CLERK - REGISTER OF DEEDS

LIBER 1893 PAGE 304

Register of Deeds Stamp & File Number

For corners in  
Calhoun  
(County)

|  |                         |               |
|--|-------------------------|---------------|
|  | Located In:             | Corner Code # |
| 1. <u>Marshall Twp.</u><br><u>Public Land Survey</u> | T 2 S R 6 W             | G-9           |
|  | T . R .                 | _____         |
|  | T . R .                 | _____         |
|  | T . R .                 | _____         |
| 2. <u>Property Controlling</u><br><u>in Section:</u> | S _____ T _____ R _____ | _____         |
|  | S _____ T _____ R _____ | _____         |
| 3. <u>Miscellaneous</u><br><u>Property in Sec.</u>   | S _____ T _____ R _____ | _____         |
|  | S _____ T _____ R _____ | _____         |
| 4. Lot No. _____, Recorded Plat _____                |                         |               |
| 5. Private Claims _____                              |                         |               |

I, Donald J. Davis, in a field survey on October 2, 1996

do hereby certify that under requirements of P.A. 74, Michigan P.A. of 1970, the corner points mentioned in lines 1 and 2 above were in conformance with regulations and rules therefore as required in the current manual of survey instructions of the United States Department of the Interior, Bureau of Land Management or by a decree of a Court of Law and/or that the corner points mentioned in lines 3, 4 and 5 above were in conformance with the rules of the Michigan Board of Land Surveyors or by a Decree of a Court of Law; established, re-established, monumented, re-monumented, recovered, found as expressed below:

**NOTE: Not more than 4 corners, all in the same town and range, may be recorded on this certificate.**

| A  | B  | C  | D  | E  | F  | G  | H | I | J | K | L | M |
|----|----|----|----|----|----|----|---|---|---|---|---|---|
| 2  | 6  | 5  | 4  | 3  | 2  | 1  |   |   |   |   |   |   |
| 3  |    |    |    |    |    |    |   |   |   |   |   |   |
| 4  | 7  | 8  | 9  | 10 | 11 | 12 |   |   |   |   |   |   |
| 5  |    |    |    |    |    |    |   |   |   |   |   |   |
| 6  | 18 | 17 | 16 | 15 | 14 | 13 |   |   |   |   |   |   |
| 7  |    |    |    |    |    |    |   |   |   |   |   |   |
| 8  | 19 | 20 | 21 | 22 | 23 | 24 |   |   |   |   |   |   |
| 9  |    |    |    |    |    |    |   |   |   |   |   |   |
| 10 | 30 | 29 | 28 | 27 | 26 | 25 |   |   |   |   |   |   |
| 11 |    |    |    |    |    |    |   |   |   |   |   |   |
| 12 | 31 | 32 | 33 | 34 | 35 | 36 |   |   |   |   |   |   |
| 13 |    |    |    |    |    |    |   |   |   |   |   |   |

Marshall Twp.

A. Description of original monument and accessories and/or subsequent restoration:

Original survey by Lyon in 1825.  
Resurvey by Gifford in 1890.  
Iron stake set by A.H. Chase in 1953.  
Stake used by M.D.S.H. in 1963.  
Stake used by DeKeyser in 1973.


B. Description of corner evidence found and/or method applied in restoring or reestablishing corner:

Found 1/2" iron pipe.  
Matches witnesses of 1953.

Accepted as good location of preserved corner.

C. Description of monument for corner and accessories established to perpetuate locating the position of the corner:

Set Berntsen monument in monument box.  
Fence line East and West.  
NW corner Twp. building S 85° E 32.44'  
SW corner Twp. building S 60° E 43.09'  
Nail & Tag 22" Maple N 40° E 34.13'  
Nail & Tag 18" Maple S 45° W 37.19'

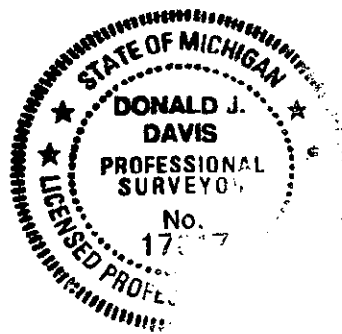

Signed by Donald J. Davis  
Surveyor's Michigan License No. 17617

Date October 15, 1996