

SURVEY & REMONUMENTATION

MAR 21 1997

COMMISSION

APPROVED
Date Oct. 16, 1996
**CALHOUN COUNTY
REMONUMENTATION.**

CALHOUN COUNTY REMONUMENTATION
LAND CORNER RECORDATION CERTIFICATE
Filing Requirement of Act 74, Mich. P.A. 1970

STATE OF MICHIGAN
CALHOUN COUNTY
RECORDED

For corners in

Calhoun

Located In:

Corner Code #

18 OCT 96 2:28 P.M.

ARNE B. NORLANDER
CLERK - REGISTER OF DEEDS

- | | | | | | |
|---------------------------------------|-------------|--------------|-------------------------|-------|--|
| <u>Marshall Twp.</u> | | | | | |
| 1. Public Land Survey | T <u>2S</u> | R <u>6 W</u> | _____ <u>G-11</u> _____ | | |
| | T _____ | R _____ | _____ | | |
| | T _____ | R _____ | _____ | | |
| | T _____ | R _____ | _____ | | |
| 2. Property Controlling
in Section | S _____ | T _____ | R _____ | _____ | |
| | S _____ | T _____ | R _____ | _____ | |
| 3. Miscellaneous
Property in Sec. | S _____ | T _____ | R _____ | _____ | |
| | S _____ | T _____ | R _____ | _____ | |
| 4. Lot No. _____, Recorded Plat _____ | | | | | |
| 5. Private Claims _____ | | | | | |

LIBER **1893** PAGE **303**

Register of Deeds Stamp & File Number

I, Donald J. Davis, in a field survey on October 3, 19 96, do hereby certify that under requirements of P.A. 74, Michigan P.A. of 1970, the corner points mentioned in lines 1 and 2 above were in conformance with regulations and rules therefore as required in the current manual of survey instructions of the United States Department of the Interior, Bureau of Land Management or by a decree of a Court of Law and/or that the corner points mentioned in lines 3, 4 and 5 above were in conformance with the rules of the Michigan Board of Land Surveyors or by a Decree of a Court of Law; established, re-established, monumented, re-monumented, recovered, found as expressed below:

NOTE: Not more than 4 corners, all in the same town and range, may be recorded on this certificate.

	A	B	C	D	E	F	G	H	I	J	K	L	M
2	6	5	4	3	2								
3													
4	7	8	9	10	11	12							
5													
6	18	17	16	15	14	13							
7													
8	19	20	21	22	23	24							
9													
10	30	29	28	27	26	25							
11													
12	31	32	33	34	35	36							

Marshall Twp.

A. Description of original monument and accessories and/or subsequent restoration:


Original survey by Lyon in 1825.
Resurvey by Gifford in 1890, tile set.
Railroad as used for witnesses no longer exists.
Tile used by Davis in survey in 1973.

B. Description of corner evidence found and/or method applied in restoring or reestablishing corner:

Found tile as used in old survey.
Old railroad bed as used for witness in resurvey of 1890, checked close.
Accepted as good perpetuation of original corner.

C. Description of monument for corner and accessories established to perpetuate locating the position of the corner:

Set Berntsen monument.
Nail & Tag 18" Cherry S 60° W 24.60'
Nail & Tag 10" Elm N 80° W 44.35'
Railroad Rail Post South 14.25'
South edge South rail M.C.R.R. North 87.56'

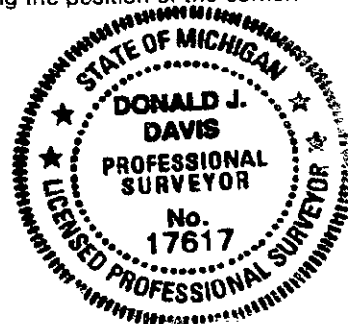

Signed by Donald J. Davis
Surveyor's Michigan License No. 17617

Date October 15, 1996