

**SURVEY &  
REMONUMENTATION**

MAR 21 1997

**COMMISSION**

**APPROVED**

Date Oct 16 1996  
**CALHOUN COUNTY  
REMONUMENTATION.**

CALHOUN COUNTY REMONUMENTATION  
**LAND CORNER RECORDATION CERTIFICATE**  
Filing Requirement of Act 74, Mich. P.A. 1970

STATE OF MICHIGAN  
CALHOUN COUNTY  
RECORDED

18 OCT 96 2:30 P.M.

ARNE S. NORLANDER  
CLERK - REGISTER OF DEEDS

LIBER **1893** PAGE **306**

Register of Deeds Stamp & File Number

For corners in

Calhoun (County)	Located In:	Corner Code #
Marshall Township		
1. Public Land Survey	T 2 S R 6 W	I-13
	T R	
	T R	
	T R	
2. Property Controlling in Section	S T R	
	S T R	
3. Miscellaneous Property in Sec.	S T R	
	S T R	

4. Lot No. \_\_\_\_\_, Recorded Plat \_\_\_\_\_  
5. Private Claims \_\_\_\_\_

I, William K. Crane, in a field survey on October 2, 1996, do hereby certify that under requirements of P.A. 74, Michigan P.A. of 1970, the corner points mentioned in lines 1 and 2 above were in conformance with regulations and rules therefore as required in the current manual of survey instructions of the United States Department of the Interior, Bureau of Land Management or by a decree of a Court of Law and/or that the corner points mentioned in lines 3, 4 and 5 above were in conformance with the rules of the Michigan Board of Land Surveyors or by a Decree of a Court of Law; established, re-established, monumented, re-monumented, recovered, found as expressed below:

**NOTE: Not more than 4 corners, all in the same town and range, may be recorded on this certificate.**

	A	B	C	D	E	F	G	H	I	J	K	L	M
2	6		5		4		3		2				
3													
4	7		8		9		10		11		12		
5													
6	18		17		16		15		14		13		
7													
8	19		20		21		22		23		24		
9													
10	30		29		28		27		26		25		
11													
12	31		32		33		34		35		36		
13													

**A. Description of original monument and accessories and/or subsequent restoration:**

Original Government Survey  
Lucius Lyon, 1825:

9" W. Oak.....N51°E.....27 links  
12" D.O.....N74°W.....49 links

Resurvey  
By James Gifford, 1890:

Set corner 12 links West of Fredonia corner.  
10" Sugar Maple.....S23½E.....40 links  
8" Yellow Oak.....N53½E.....81 links

LCRC, L. 1106, P. 914, 1976 by  
Robert Carr:

3/4" iron in monument box in line with fence North on centerline of road East.  
24" Maple.....S20°E.....27.30'  
20" Maple.....S55°W.....47.63'

**B. Description of corner evidence found and/or method applied in restoring or reestablishing corner:**


Found 3/4" iron driven into a hollow tile in monument box as recorded in LCRC above with all references in place.

**C. Description of monument for corner and accessories established to perpetuate locating the position of the corner:**

Replaced 3/4" iron and tile with standard Calhoun County Remonumentation Monument (Bernsten Monument) in monument box.

Set nail & tag in 26" Maple.....S20°E.....27.22'  
Set nail & tag in 22" Maple.....S55°W.....47.56'  
3/4" iron in mon. box (Fredonia Cor).....East.....7.80'  
Dekeyser capped iron.....North.....39.97'

This is accepted as the best available evidence of the position of the original corner.

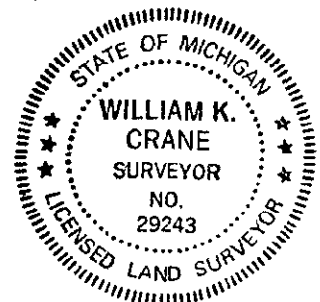

Signed by William K. Crane  
Surveyor's Michigan License No. 29243

Date October 16, 1996