

MAR 30 1999

APPROVED

SECTION

Date 12-7-98 RRC
CALHOUN COUNTY
REMONUMENTATION.

CALHOUN COUNTY REMONUMENTATION
LAND CORNER RECORDATION CERTIFICATE
Filing Requirement of Act 74, Mich. P.A. 1970

STATE OF MICHIGAN
CALHOUN COUNTY
RECORDED

For corners in

<u>CALHOUN</u> (County)	Located In:	Corner Code #
MARSHALL	T2S R6W	K-3
1. Public Land Survey	T R	
	T R	
	T R	
2. Property Controlling in Section	S T R	
	S T R	
3. Miscellaneous Property in Sec.	S T R	
	S T R	

15 DEC 1998 3:37:18 PM

ANNE B. NORLANDER
CLERK - REGISTER OF DEEDS

LIBER 2087 PAGE 934

Register of Deeds Stamp & File Number

4. Lot No. _____, Recorded Plat _____
5. Private Claims _____

I, Michael A Groat, in a field survey on December 1, 1998 do hereby state that under requirements of P.A. 74, Michigan P.A. of 1970, the corner points mentioned in lines 1 and 2 above were in conformance with regulations and rules therefore as required in the current manual of survey instructions of the United States Department of the Interior, Bureau of Land Management or by a decree of a Court of Law and for that the corner points mentioned in lines 3, 4 and 5 above were in conformance with the rules of the Michigan Board of Land Surveyors or by a Decree of a Court of Law; established, re-established, monumented, recovered, found as expressed below:

NOTE: Not more than 2 corners, all in the same town and range, may be recorded on this certificate.

	A	B	C	D	E	F	G	H	I	J	K	L	M
1													
2	6		5		4		3		2		1		
3													
4	7		8		9		10		11		12		
5													
6	10		17		16		15		14		13		
7													
8	19		20		21		22		23		24		
9													
10	30		29		28		27		26		25		
11													
12	31		32		33		34		35		36		
13													

A. Description of original monument and accessories and/or subsequent restoration:


ORIGINAL SURVEY, LUCIUS LYON, DEPUTY SURVEYOR, 1825, SET POST W. OAK, 16", N 63 3/4 W, 208 LKS, W. OAK, 7", S 89° E, 699 LKS.
JAMES GIFFORD, 1890, FOUND STUMP OF BOTH BEARING TREES, SET STAKE, W. OAK, 14", EAST 725 LKS.
1966, 3/4" PIPE INSIDE TILE, 16' WEST OF FENCE, IN LINE WITH FENCE EAST 6" MAPLE, N 45° E, 26.85'

B. Description of corner evidence found and/or method applied in restoring or reestablishing corner:

FOUND HOLLOW TILE WITH PIPE INSIDE WITH STONES AROUND. ACCEPTED AS A FAITHFUL & CAREFUL PERPETUATION OF THE ORIGINAL MONUMENT.

C. Description of monument for corner and accessories established to perpetuate locating the position of the corner:

SET BERNTSEN MONUMENT IN PLACE OF TILE.
NAIL & TAG IN 8" OAK, N 35° W, 5.8'
NAIL & TAG IN 14" MAPLE, N 40° E, 26.8'
NAIL & TAG IN 7" ASH, S 30° W, 9.9'
NAIL & TAG IN 12" OAK, S 45° E, 31.75'
16' WEST OF NORTH-SOUTH FENCE
CARSONITE MARKER ON NORTH SIDE

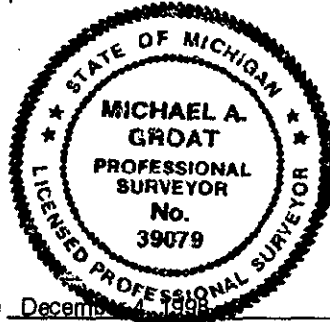

Signed by [Signature]
Surveyor's Michigan License No. 39079

Date December 1, 1998