

SURVEY & REMONUMENTATION

OCT 24 1994

APPROVED

Date 8-17-94
CALHOUN COUNTY REMONUMENTATION.

COMMISSION
CALHOUN COUNTY REMONUMENTATION

LAND CORNER RECORDATION CERTIFICATE
Filing Requirement of Act 74, Mich. P.A. 1970

STATE OF MICHIGAN
CALHOUN COUNTY
RECORDED

18 AUG 94 12:07 P.M.

ANNE B. NORLANDER
CLERK - REGISTER OF DEEDS

Register of Deeds Stamp & File Number

For corners in Calhoun (County) Located In: _____ Corner Code # _____

1. Public Land Survey	T <u>2</u> S <u>6</u> W	<u>K-11</u>
	T _____ R _____	_____
	T _____ R _____	_____
	T _____ R _____	_____
2. Property Controlling in Section	S _____ T _____ R _____	_____
	S _____ T _____ R _____	_____
3. Miscellaneous Property in Sec.	S _____ T _____ R _____	_____
	S _____ T _____ R _____	_____
4. Lot No. _____, Recorded Plat _____		
5. Private Claims _____		

A	B	C	D	E	F	G	H	I	J	K	L	M
2	6	5	4	3	2	1						
3												
4	7	8	9	10	11	12						
5												
6	18	17	16	15	14	13						
7												
8	19	20	21	22	23	24						
9												
10	30	29	28	27	26	25						
11												
12	31	32	33	34	35	36						
13												

I, Donald J. Davis, in a field survey on August 13, 1994, do hereby certify that under requirements of P.A. 74, Michigan P.A. of 1970, the corner points mentioned in lines 1 and 2 above were in conformance with regulations and rules therefore as required in the current manual of survey instructions of the United States Department of the Interior, Bureau of Land Management or by a decree of a Court of Law and/or that the corner points mentioned in lines 3, 4 and 5 above were in conformance with the rules of the Michigan Board of Land Surveyors or by a Decree of a Court of Law; established, re-established, monumented, re-monumented, recovered, found as expressed below:

NOTE: Not more than 4 corners, all in the same town and range, may be recorded on this certificate.

A. Description of original monument and accessories and/or subsequent restoration:

Not included in resurvey. R. Carr, 3-10-72
 Platted in 1839, as Village of Marshall. Iron in Box.
 Hydrant N.E. 37.2'
 20" Maple N 30° W, 54.1'
 U.P. S 45° W, 32.20'

SURVEY & REMONUMENTATION

OCT 24 1994

COMMISSION


B. Description of corner evidence found and/or method applied in restoring or reestablishing corner:

Found 3/4" iron in monument box and checked to R. Carr witnesses (1972). Also found pieces of old brick.
 Held as good perpetuation of original monument.

LIBER 1763 PAGE 755

C. Description of monument for corner and accessories established to perpetuate locating the position of the corner:

Set Berntsen monument in monument box.
 Nail & Spotter in U.P., N 60° W, 54.05'
 Nail & Spotter in U.P., N 30° E, 52.41'
 Nail & Spotter in U.P., S 45° W, 43.30'
 Nail & Spotter in U.P., N 75° E, 74.45'

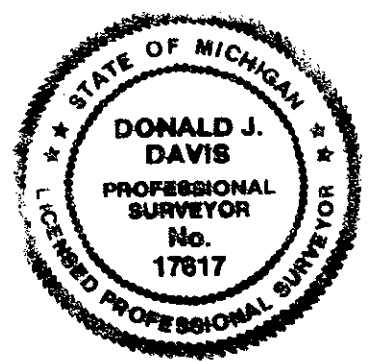

Signed by Donald J. Davis
 Surveyor's Michigan License No. 17617

Date August 17, 1994