

APPROVED
 Date 8-17-94 *DJD*
CALHOUN COUNTY
REMONUMENTATION.

CALHOUN COUNTY REMONUMENTATION
LAND CORNER RECORDATION CERTIFICATE
 Filing Requirement of Act 74, Mich. P.A. 1970

STATE OF MICHIGAN
 CALHOUN COUNTY
 RECORDED

18 AUG 94 12:07 P.M.

ANNE B. NORLANDER
 CLERK - REGISTER OF DEEDS

For corners in

Calhoun
 (County)

Located In:

Corner Code #

- | | | |
|------------------------------------|---------------------------|--------------|
| 1. Public Land Survey | T <u>2</u> S R <u>6</u> W | <u>L-115</u> |
| | T _____ R _____ | _____ |
| | T _____ R _____ | _____ |
| | T _____ R _____ | _____ |
| 2. Property Controlling in Section | S _____ T _____ R _____ | _____ |
| | S _____ T _____ R _____ | _____ |
| 3. Miscellaneous Property in Sec. | S _____ T _____ R _____ | _____ |
| | S _____ T _____ R _____ | _____ |

Register of Deeds Stamp & File Number

4. Lot No. _____, Recorded Plat _____
 5. Private Claims _____

	A	B	C	D	E	F	G	H	I	J	K	L	M
2	6	5	4	3	2	1							
3													
4	7	8	9	10	11	12							
5													
6	18	17	16	15	14	13							
7													
8	19	20	21	22	23	24							
9													
10	30	29	28	27	26	25							
11													
12	31	32	33	34	35	36							
13													

Donald J. Davis, in a field survey on August 13, 19 94, do hereby certify that under requirements of P.A. 74, Michigan P.A. of 1970, the corner points mentioned in lines 1 and 2 above were in conformance with regulations and rules therefore as required in the current manual of survey instructions of the United States Department of the Interior, Bureau of Land Management or by a decree of a Court of Law and/or that the corner points mentioned in lines 3, 4 and 5 above were in conformance with the rules of the Michigan Board of Land Surveyors or by a Decree of a Court of Law; established, re-established, monumented, re-monumented, recovered, found as expressed below:

NOTE: Not more than 4 corners, all in the same town and range, may be recorded on this certificate.

A. Description of original monument and accessories and/or subsequent restoration:

Not included in resurvey. No name or date.
 Platted in 1839 as Village of Marshall, Hydrant, N.W. 44.8'
 Elm N.E 38'
 4' South of Sewer manhole.

B. Description of corner evidence found and/or method applied in restoring or reestablishing corner:

Found 1/2" iron with bricks around. Checked into old witnesses.
 Accepted as good perpetuation of original corner.

**SURVEY &
 REMONUMENTATION**


LIBER 1763 PAGE 752

OCT 24 1994

COMMISSION

C. Description of monument for corner and accessories established to perpetuate locating the position of the corner:

Set Berntsen monument and monument box.
 Nail & Spotter in U.P. N 65° W, 44.70'
 Nail & Spotter in U.P. N 70° E, 53.40'
 Nail & Spotter in U.P. S 20° W, 75.05'
 Nail & Spotter in U.P. S 45° E, 45.70'

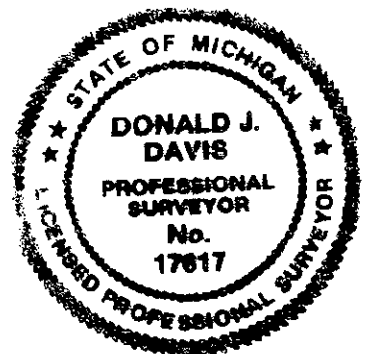

Signed by Donald J. Davis Date August 17, 1994
 Surveyor's Michigan License No. 17617