

APPROVED

Date 8-17-94 DJD  
CALHOUN COUNTY  
REMONUMENTATION.

CALHOUN COUNTY REMONUMENTATION

LAND CORNER RECORDATION CERTIFICATE  
Filing Requirement of Act 74, Mich. P.A. 1970

For corners in

<u>Calhoun</u> (County)	Located In:	Corner Code #
1. Public Land Survey	T <u>2</u> S R <u>6</u> W	<u>L-13</u>
	T _____ R _____	_____
	T _____ R _____	_____
	T _____ R _____	_____
2. Property Controlling in Section	S _____ T _____ R _____	_____
	S _____ T _____ R _____	_____
3. Miscellaneous Property in Sec.	S _____ T _____ R _____	_____
	S _____ T _____ R _____	_____
4. Lot No. _____, Recorded Plat _____		
5. Private Claims _____		

STATE OF MICHIGAN  
CALHOUN COUNTY  
RECORDED

18 AUG 94 12:07 P.M.

ANNE B. NORLANDER  
CLERK - REGISTER OF DEEDS

Register of Deeds Stamp & File Number

I, Donald J. Davis, in a field survey on August 17, 19 94, do hereby certify that under requirements of P.A. 74, Michigan P.A. of 1970, the corner points mentioned in lines 1 and 2 above were in conformance with regulations and rules therefore as required in the current manual of survey instructions of the United States Department of the Interior, Bureau of Land Management or by a decree of a Court of Law and/or that the corner points mentioned in lines 3, 4 and 5 above were in conformance with the rules of the Michigan Board of Land Surveyors or by a Decree of a Court of Law; established, re-established, monumented, re-monumented, recovered, found as expressed below:

NOTE: Not more than 4 corners, all in the same town and range, may be recorded on this certificate.

A	B	C	D	E	F	G	H	I	J	K	L	M
2	6	5	4	3	2	1						
3												
4	7	8	9	10	11	12						
5												
6	18	17	16	15	14	13						
7												
8	19	20	21	22	23	24						
9												
10	30	29	28	27	26	25						
11												
12	31	32	33	34	35	36						
13												

A. Description of original monument and accessories and/or subsequent restoration:

- |                                     |   |
|-------------------------------------|---|
| REsurvey, 1890 by James M. Gifford. | R. Carr, 3-10-72                                |
| Set Stake                           | 1/2" iron 0.5' <sup>SW</sup> from fence corner. |
| 6" Hickory S 10° E, 146 links       | 12" Hickory West, 25.50'                        |
| 5" Hickory West 242 links           | 14" Hickory South, 95.51'                       |
|                                     | Hydrant, N 50° W, 47.43'                        |

B. Description of corner evidence found and/or method applied in restoring or reestablishing corner:

- Found P.K. Nail in concrete fence post base.
- Measured to Carr witnesses from 1972.
- Assumed iron was torn out when cement was poured.
- Held as good perpetuation of original corner.

LIBER 1763 PAGE 751


SURVEY &  
REMONUMENTATION

OCT 24 1994

COMMISSION

C. Description of monument for corner and accessories established to perpetuate locating the position of the corner:

- Set Berntsen monument with carsonite marker beside.
- Nail & Spotter 14" Hickory West, 25.5' (old)
- Nail & Spotter 18" Hickory South, 95.51' (old)
- Fire Hydrant, N 50° W, 47.43' (old)
- Wood fence post, N 45° E, 3.5'

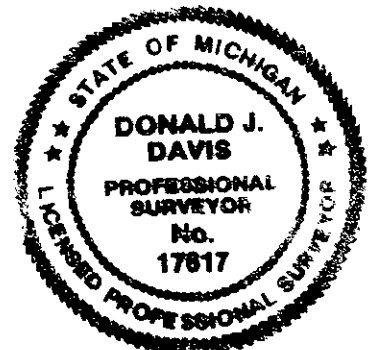

Signed by Donald J. Davis  
Surveyor's Michigan License No. 17617

Date August 17, 1994