

APPROVED

Date 10-20-99 RRL

CALHOUN COUNTY
REMONUMENTATION.

CALHOUN COUNTY REMONUMENTATION
LAND CORNER RECORDATION CERTIFICATE
Filing Requirement of Act 74, Mich. P.A. 1970

STATE OF MICHIGAN
CALHOUN COUNTY
RECORDED

For corners in

CALHOUN

Located In:

Corner Code #

(County)

EMMETT TOWNSHIP

1. Public Land Survey

T 2S R 7W

F-5

T R

T R

T R

2. Property Controlling
in Section

S

T R

S

T R

3. Miscellaneous

S

T R

Property in Sec.

S

T R

3 DEC 1999 2:43:44 PM

ANNE B. NORLANDER
CLERK - REGISTER OF DEEDS

LIBER **2182** PAGE **427**

Register of Deeds Stamp & File Number

4. Lot No. _____, Recorded Plat _____
5. Private Claims _____

I, Michael A. Groat, in a field survey on October 5, 19 99 do hereby state that under requirements of P.A. 74, Michigan P.A. of 1970, the corner points mentioned in lines 1 and 2 above were in conformance with regulations and rules therefore as required in the current manual of survey instructions of the United States Department of the Interior, Bureau of Land Management or by a decree of a Court of Law and for that the corner points mentioned in lines 3, 4 and 5 above were in conformance with the rules of the Michigan Board of Land Surveyors or by a Decree of a Court of Law; established, re-established, monumented, recovered, found as expressed below:

NOTE: Not more than 2 corners, all in the same town and range, may be recorded on this certificate.

	A	B	C	D	E	F	G	H	I	J	K	L	M
1													
2	6	5	4	3	2	1							
3													
4	7	8	9	10	11	12							
5													
6	18	17	16	15	14	13							
7													
8	19	20	21	22	23	24							
9													
10	30	29	28	27	26	25							
11													
12	31	32	33	34	35	36							
13													

A. Description of original monument and accessories and/or subsequent restoration:


ORIGINAL SURVEY, SYLVESTER SIBLEY, 1826, SET POST AT 39.77 CHAINS, W. OAK, 10", NORTH 48° WEST, 12 LINKS; W. OAK 12", SOUTH 78° EAST, 10 LINKS.
RE-SURVEY, F. HODGEMAN, 1889, FOUND STAKE & STONES, SET POST, W. OAK 3", NORTH 40° WEST, 9 LINKS, 8" HICKORY, 3", SOUTH 15° WEST, 8-1/2 LINKS
P.E. ROSENDALE, 9-23-80 FD C.P. CO MONUMENT, TILE ON EAST SIDE, SOUTH 70° EAST, 42.45', POWER POLE EAST, 69.23', 12" PINE, NORTH 30° EAST, 78.15', 9" PINE.

B. Description of corner evidence found and/or method applied in restoring or reestablishing corner:

FOUND CONSUMERS POWER MONUMENT WITH CONCRETE AROUND IN NORTH-SOUTH FENCE. TILE BESIDE. WITNESSES FROM ROSENDALE MATCHED. ACCEPTED THE POSITION OF THE TILE AS A CAREFUL & FAITHFUL REPRESENTATION OF THE ORIGINAL MONUMENT.
REPLACED THE TILE WITH A BERNTSEN MONUMENT & LEFT THE C.P. CO. MARKER BESIDE.

C. Description of monument for corner and accessories established to perpetuate locating the position of the corner:

WITNESSES TO THE TILE
NAIL & TAG IN P. POLE, NORTH 10° EAST, 65.50'
NAIL & TAG IN 14" SCOTCH PINE, SOUTH 80° EAST, 68.43'
NAIL & TAG IN 8" WHITE PINE, NORTH 30° EAST, 74.75'
NAIL & TAG IN POWER POLE, SOUTH 70° WEST, 43.15'
CARSONITE MARKER, SOUTH 80° WEST, 0.8'
CONSUMERS POWER MONUMENT, WEST 0.50'

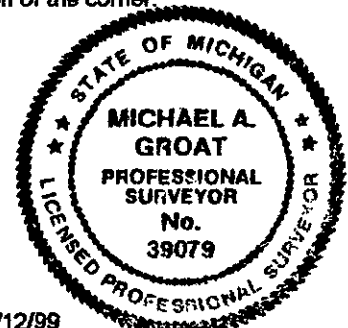

Signed by [Signature]

Date 10/12/99

Surveyor's Michigan License No. 39079

FORM APPROVED BY MICHIGAN STATE BOARD OF PROFESSIONAL SURVEYORS, JAN. 28, 1971
REVISED MAY 14, 1978

REVISED JAN. 1983
REVISED OCT. 1988

SURVEY &
REMONUMENTATION

MAR 13 2000

SECTION