

APPROVED

Date 11-12-96  
CALHOUN COUNTY  
REMONUMENTATION  
For corners in

CALHOUN COUNTY REMONUMENTATION  
LAND CORNER RECORDATION CERTIFICATE  
Filing Requirement of Act 74, Mich. P.A. 1970

STATE OF MICHIGAN  
CALHOUN COUNTY  
RECORDED

19 NOV 96 1:53 P.M.

ANNE B. NORLANDER  
CLERK - REGISTER OF DEEDS

LIBER 1899 PAGE 602

Register of Deeds Stamp & File Number

Calhoun <small>(County)</small>	Located In:	Corner Code #
Emmett Twp		
1. Public Land Survey Sec 4	T 2 S R 7 W	G-1
	T _____ R _____	_____
	T _____ R _____	_____
	T _____ R _____	_____
2. Property Controlling in Section	S _____ T _____ R _____	_____
	S _____ T _____ R _____	_____
3. Miscellaneous Property in Sec.	S _____ T _____ R _____	_____
	S _____ T _____ R _____	_____

4. Lot No. \_\_\_\_\_, Recorded Plat \_\_\_\_\_  
5. Private Claims \_\_\_\_\_

A	B	C	D	E	F	G	H	I	J	K	L	M
2	6	5	4	3	2	1						
3												
4	7	8	9	10	11	12						
5												
6	18	17	16	15	14	13						
7												
8	19	20	21	22	23	24						
9												
10	30	29	28	27	26	25						
11												
12	31	32	33	34	35	36						
13												

Emmett Township

I, Robert R. Carr, in a field survey on October 23, 19 96, do hereby certify that under requirements of P.A. 74, Michigan P.A. of 1970, the corner points mentioned in lines 1 and 2 above were in conformance with regulations and rules therefore as required in the current manual of survey instructions of the United States Department of the Interior, Bureau of Land Management or by a decree of a Court of Law and/or that the corner points mentioned in lines 3, 4 and 5 above were in conformance with the rules of the Michigan Board of Land Surveyors or by a Decree of a Court of Law; established, re-established, monumented, re-monumented, recovered, found as expressed below:

NOTE: Not more than 4 corners, all in the same town and range, may be recorded on this certificate.

- A. Description of original monument and accessories and/or subsequent restoration:
1. G.L.O.; Sibley 1826
  2. Hodgeman, 1889, found stake at end of fence from South, set post (tile).
  3. Plat of "Blakes Corners" Liber 6, page 47.

B. Description of corner evidence found and/or method applied in restoring or reestablishing corner:

Found 8" long piece of tile lying on top of 4" diameter concrete base of 6" diameter steel corner post.

Checked distances from 6" steel post to iron pipe at SE corner Lot 53 of "Blakes Corners" and iron pipe at NW corner Lot 53 and found them good.

Hodgeman witnesses gone.


Accepted 6" steel post in concrete as best evidence of corner.

SURVEY & REMONUMENTATION

MAR 21 1997

COMMISSION

- C. Description of monument for corner and accessories established to perpetuate locating the position of
- 6" diameter steel post 4.7 feet tall in concrete base.
- Nail & spotter Easterly side 10" Oak N27°W 34.35 feet.
  - Nail & spotter Northerly side 16" Oak S79°W 35.55 feet.
  - Nail & spotter Northwesterly side twin 12"-14" cherry S17°W 15.05 feet.
  - Nail & spotter Southeasterly side of 8" cherry N61°E 49.23 feet.
  - Nail & spotter Easterly side of 12" Hickory N06°E 39.40 feet.

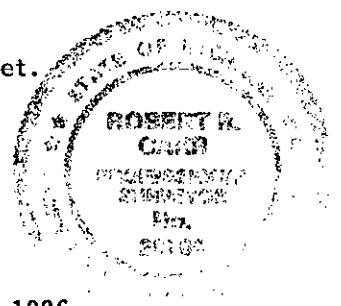

Signed by Robert R. Carr Date November 8, 1996  
 Surveyor's Michigan License No. 20704